

RANKIN MISSISSIPPI BOARD OF WATER COMMISSIONERS

T 18

3-2-64

WATER WELL DRILLERS LOG

Date: 3-2-, 1964, Driller: James McNEE County: Winds
(Name)

CODED

(1) Owner of Land Mrs. T.J. Suddeck
(Name)

FLORENCE MISS

(Address)

(2) Location: 1/4, 1/4, Sec. 3 T3R1,

4 miles SW of FLORENCE
(distance) (direction) (Nearest Town)

(3) Topography: ↓
(Hilly) (Flat) (Level)

(4) Purpose of Well: Domestic
(Domestic Irrigation, Municipal, Industrial, Other)

Description & Color of Materials Sand, Clay, Red Clay, Shell, etc.	Thick- ness Feet	Depth Feet
SURFACE SOIL	10	10
SAND	106	116
Grey shale	130	246
Lime sh strks	25	271
SANDY sh	5	276
Grey shale	11	287
SAND	6	293
Grey sh SAND strks	25	318
grey sh lignite	21	339

Information upon completion of well:

(1) Diameter 2 inches.

(2) Total Depth _____ feet.

(3) Water Level 150' feet below top of ground.

(4) Cased to 249', Size 2"

(5) Screen: Size NONE, Length _____.

(6) Were any formations sealed against pollution?

_____ yes, no.


If YES, depth of formation _____.

Why _____.

Drillers Remarks: _____.

12 ft 2" 248
2-3" x 2" 20 ft
2nd 34' 249

CODED

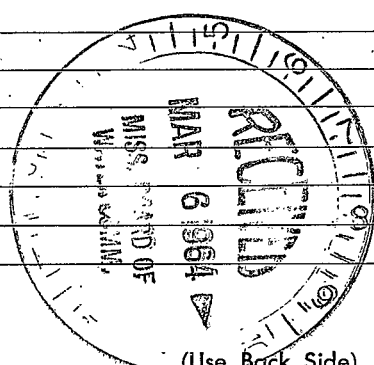

(Use Back Side)

Well No.

