

RANKIN MISSISSIPPI BOARD OF WATER COMMISSIONERS

T 19

1-25-66

WATER WELL DRILLERS LOG

CODED

Date: 1/25, 19 66, Driller: Ben Burney

County Ranklin

(Name)

- (1) Owner of Land: Ellen Ward
(Name)
Route 2, Box 76
(Address)
- (2) Location: 1/4, 1/4, Sec 29 T5 R1, of Terry
5 miles SE (direction), of Terry (Nearest Town)
- (3) Topography: Hilly
(Hilly) (Flat) (Level)
- (4) Purpose of Well: Domestic
(Domestic Irrigation, Municipal, Industrial, Other)

Description & Color of Materials Sand, Clay, Red Clay, Shell, etc.	Thick-ness Feet	Depth Feet
Red & gray top soil	12	12
Sand	11	23
Buckshot clay	15	38
Med white sand	8	46
Rock	1 1/2	47 1/2

Information upon completion of well:


- (1) Diameter 6 1/2" inches.
- (2) Total Depth 47' feet.
- (3) Water Level 28' feet below top of ground.
- (4) Cased to 41', Size 4"
- (5) Screen: Size 4", Length 7'
- (6) Were any formations sealed against pollution?
X yes, no.

If YES depth of formation 10'

Why To prevent surface pollution

Drillers Remarks: Sanitary well seal used.

CODED

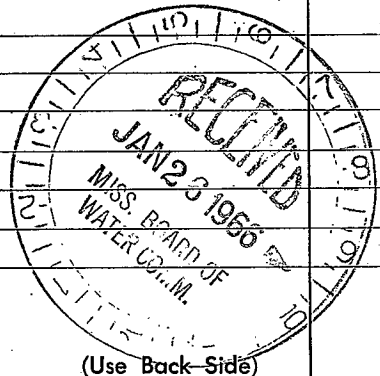

Well No.

100