

MISSISSIPPI BOARD OF WATER COMMISSIONERS

RANKIN
T 20
5-13-65

WATER WELL DRILLERS LOG

CODED

Date: May 13, 1965, Driller: Burney Water Well Service County Rankin

(Name)

(1) Owner of Land: S. H. Ward

(Name)

Rt. 2 Terry, Miss.

(Address)

Rosemarry Road

(2) Location: 1/4, 1/4, Sec. 29 T 3 R 1

5 1/2 miles SE of Terry

(distance)

(direction)

(Nearest Town)

(3) Topography: Hilly

(Hilly)

(Flat)

(Level)

(4) Purpose of Well: Domestic

(Domestic Irrigation
 Municipal, Industrial, Other)

Description & Color of Materials Sand, Clay, Red Clay, Shell, etc.	Thick- ness Feet	Depth Feet
Top soil & clay	15'	15
Fine white sand	3	18
Grey clay	12	30
Fine yellow sand	12	42
Coarse white sand (best)	4	46
Clay	4	50
Sand	3	53
Hard rock formation (bit roller)	16	69
Hard Grey Shale	5	74
Blue Clay	26	100
Fine sand (Best)	3	103
Shale & Clay	19	122
Hard shale	10	132
Rock	5	137
Shale & Rock formation	5	142
Blue clay	4	146
Rock	END	

Information upon completion of well:

(1) Diameter 6" inches.

(2) Total Depth 146 feet.

(3) Water Level 28 feet below top of ground.

(4) Cased to 42', Size 4"

(5) Screen: Size 4", Length 7'

(6) Were any formations sealed against pollution?


X yes, no.

If YES depth of formation From Surface

Why to prevent surface pollution

Drillers Remarks: Well seal used

CODED

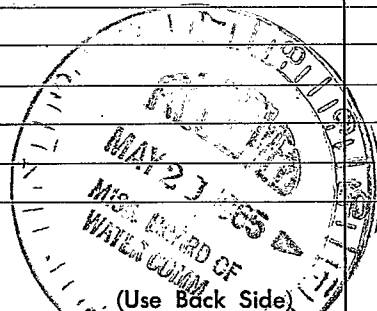

Well No.

