

Rankin  
T 21  
9-23-68

MISSISSIPPI  
BOARD OF WATER COMMISSIONERS  
416 North State Street  
Jackson, Mississippi 39201

**CODED**

CODED

WATER WELL DRILLERS LOG

9-23 1968 date well completed  
Fast Drilling firm name  
Rankin county well located

LANDOWNER: C.W. Sweeney  
P.O. Box 134  
Florence Miss.  
(mailing address)

WELL LOCATION:  
sec. 10 T 3 N R 1 E  
2 1/2 miles SW of Florence  
(distance) (direction) (nearest town)

WELL PURPOSE: Home  
(home, irrigation, municipal, industrial)

WELL COMPLETION DATA:

- (1) diameter (inches) 2"
- (2) total depth (feet) 815
- (3) static water level (feet) 144 below top of ground.
- (4) casing 2" Galv. 800 (material) (depth)
- (5) screen 2" 15' 800 (length) (depth to top) (material) (size)
- (6) pump 2 1/2 HP 46 (type) (yield gpm)
- (7) electric log no (yes or no)
- (8) how well bottom plugged Perched

description of formations encountered	from	to
Clay + Sand	0	10
Clay		20
blue clay + silt band		40
Clay		102
Clay + silt sandy shale		122
Clay		148
Rock		150
Clay + shell		169
Rock		175
Clay + Rock		184
Clay + silt sandy shale		204
Clay + silt shale		276
Sand		275
Soft shale + silt		285
Hard + silt shale		275
fine sand + silt shale		800
fine sand		815

CODED

CODED


JAN - 7 1969

MISS. BD. OF  
WATER COMMISSIONERS

DRILLERS REMARKS:

If well telescopes please sketch and show depths.

GROUND LEVEL

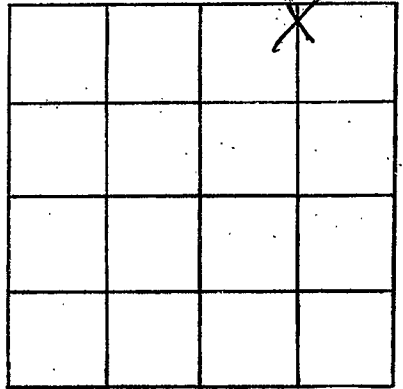

SECTION 10

Please indicate well location X.

ADDITIONAL INFORMATION

If more than one screen,  
show locations of each on sketch.