

Rankin
T 22
11-29-68

MISSISSIPPI
 BOARD OF WATER COMMISSIONERS ^{CODED}
 416 North State Street
 Jackson, Mississippi 39201

CODED

WATER WELL DRILLERS LOG

November 29 19 68 Burney Water Well Service, Inc. Rankin
 date well completed firm name county well located

LANDOWNER: Mt. Zion Baptist Church
Route 2
Terry, Miss.
 (mailing address)

WELL LOCATION:
 sec. 32 T. 3 N R. 1 E
 * * * * *
5 miles East of Terry
 (distance) (direction) (nearest town)

description of formations encountered	from	to
Red top soil	0	8
Red & white sand	8	46
Water sand	46	62
Blue & yellow clay	62	68
Hard rock	68	70

WELL PURPOSE: Home
 (home, irrigation, municipal, industrial)

WELL COMPLETION DATA:

(1) diameter (inches) 6"

(2) total depth (feet) 70'

(3) static water level (feet) 44 below top of ground. ~~above~~

(4) casing PVC 58'
 (material) (depth)
 (size) if telescope see back.

(5) screen 5' 58'
 (length) (depth to top)
4" Johnson SS No. 7
 (size) (material)

(6) pump Used customer's pump
 (HP) (yield gpm)
900GPH with 20Lbs. air
600GPH (type power) with rig.

(7) electric log no
 (yes or no)

CODED

CODED

(organization running log)

(8) how well bottom plugged. Backwash valve used

DRILLERS REMARKS:

DEC - 2 1968
 MISS. BD. OF WATER COMMISSIONERS


If well telescopes please sketch and show depths.

GROUND LEVEL

58' 4" PVC Casing

5' 4"
Johnson SS
Screen No. 7

Back wash
valve (special)

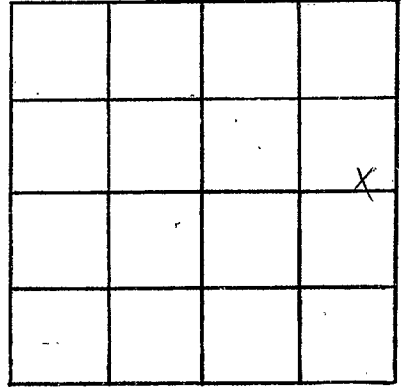

SECTION 32

Please indicate well location X.

ADDITIONAL INFORMATION

If more than one screen,
show locations of each on sketch.