

MT Zion

MISSISSIPPI BOARD OF WATER COMMISSIONERS  
416 North State Street  
Jackson, Mississippi 39201

BAP CAMROH

CODED

RANKIN  
123  
9-18-69

WATER WELL DRILLERS LOG

Sept 18 1969 Thompson Well Dr. Rankin  
date well completed firm name county well located

LANDOWNER: PINSON  
T. C. Pinson  
Telomene Miss.  
(mailing address)  
WELL LOCATION: NE, NW, NE  
sec 28 T. 3 N R. E  
MT Zion  
(distance) miles (direction) of (nearest town)

description of formations encountered	from	to
sandy	0	20
blue clay	20	98
sand	98	107
Blue Clay	107	159

WELL PURPOSE: Home  
(home, irrigation, municipal, industrial)

WELL COMPLETION DATA:  
(1) diameter (inches) 2"  
(2) total depth (feet) 139'  
(3) static water level (feet) 66' below top of ground.  
(4) casing (material) (depth) 2" if telescope see back.  
(5) screen (length) (depth to top) 6' 100'  
(6) pump (HP) (yield gpm) 3/4 Gal. Walker's  
(type power) Gal.  
(7) electric log Yes (yes or no) USGS  
(organization running log)  
(8) how well bottom plugged B/W


CODED

UPT 21  
MISS. DEP. OF WATER RESOUR.

DRILLERS REMARKS:  
i can't find location on map.

If well telescopes please sketch and show depths.

GROUND LEVEL

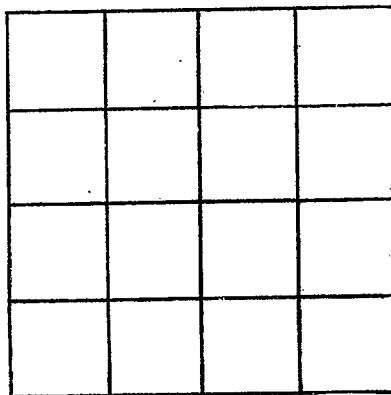

SECTION \_\_\_\_\_

Please indicate well location X.

ADDITIONAL INFORMATION

If more than one screen, show locations of each on sketch.