

Rankin
T 27
12-20-69

MISSISSIPPI
 BOARD OF WATER COMMISSIONERS **CODED**
 416 North State Street
 Jackson, Mississippi 39201

WATER WELL DRILLERS LOG

Dec 20 1969 R.E. Thompson Rankin
 date well completed firm name county well located


LANDOWNER:	description of formations encountered	from	to
<u>Shed Byrd</u>			
<u>Terry Jones</u> (mailing address)	<u>Red sand</u>	<u>38</u>	<u>63</u>
WELL LOCATION: sec <u>32</u> T <u>3</u> N R <u>1</u> E 10 miles <u>S/W</u> of <u>Abbeville</u> (distance) (direction) (nearest town)	<u>sand</u>	<u>63</u>	<u>71</u>
WELL PURPOSE: <u>Home</u> (home, irrigation, municipal, industrial)	<u>Blue clay & Rock</u>	<u>71</u>	<u>127</u>
WELL COMPLETION DATA:	<u>sand & clay</u>	<u>127</u>	<u>160</u>
(1) diameter (inches) <u>2"</u>			
(2) total depth (feet) <u>160</u>			
(3) static water level (feet) _____ below above top of ground.			
(4) casing <u>Plastic, 120'</u> (material) (depth) <u>2"</u> if telescope see back. (size)			
(5) screen <u>open hole</u> (length) (depth to top) (size) (material)			
(6) pump <u>3/4</u> <u>6</u> (HP) (yield gpm) <u>Just</u> (type power)			
(7) electric log <u>no</u> (yes or no) (organization running log)			
(8) how well bottom plugged <u>open</u>			
DRILLERS REMARKS:			

JAN 7 1970

MISS. BD. OF
 WATER COMM.

If well telescopes please sketch and show depths.

GROUND LEVEL

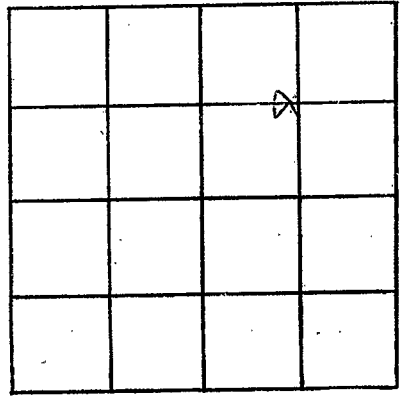

SECTION 32

Please indicate well location X.

ADDITIONAL INFORMATION

If more than one screen,
show locations of each on sketch.