

RANKIN

~~POST~~ 39

12-61

WATER WELL DRILLERS LOG

CODED

Date: Dec, 1961, Driller: Stater Gordon County Rankin

(Name)

(1) Owner of Land: Ray Gordon
 (Name)
Florence, Miss
 (Address)

(2) Location: 1/4, 1/4, Sec. 10 T3R1,
3/4 miles NE, of Florence,
 (distance) (direction) (Nearest Town)

(3) Topography: (Hilly) (Flat) (Level)

(4) Purpose of Well: domestic
 (Domestic, Irrigation, Municipal, Industrial, Other)

Information upon completion of well:

(1) Diameter 2 inches.

(2) Total Depth 251 feet.

(3) Water Level 105 feet below top of ground.

(4) Cased to 230, Size 2.

(5) Screen: Size 1/2", Length _____.

(6) Were any formations sealed against pollution?
 _____ yes, _____ no.


If YES depth of formation _____

Why _____

Drillers Remarks: _____

Description & Color of Materials Sand, Clay, Red Clay, Shell, etc.	Thick- ness Feet	Depth Feet
Red & Yel		
Sand		38
Light Blue	38	
Darker Grey Clay		
Clay w/ shell strat	115	
Top Rock	135	137
Rotten Lime	237	141
Rock	141	143 1/2
Rotten Lime	143 1/2	146
Rock	146	150
Rock & Lime		155
Lime	155	165
Shell strat	165	166
Mealy sd	166	169
Very fine silty sand	169	186
Clay	186	191
Sdy	191	194
Clay	191	197
Sdy	197	203
Clay w/ sd str	203	211 1/2
sd	212	
sd	221	226
Clay & sd str	226	233
Very fine dr grey	243	251

CODED

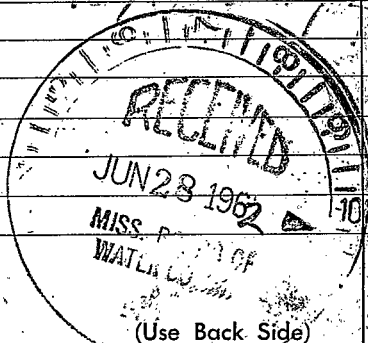

Well No.

VII

1900