

RANKIN MISSISSIPPI BOARD OF WATER COMMISSIONERS

~~057~~ T 41

3-26-64

WATER WELL DRILLERS LOG

Rankin
Scott

CODED

Date: 3/26, 1964, Driller: Forest Dwyer, County: Rankin
(Name)

(1) Owner of Land	Description & Color of Materials Sand, Clay, Red Clay, Shell, etc.	Thick- ness Feet	Depth Feet
<u>Raymond Estate</u> (Name) <u>Wm. J. Raymond</u> <u>Rt 2 Florence, Miss.</u> (Address)	Clay	0	12
	Sand		25
	Blue shale + rock		60
(2) Location: <u>1/4</u> , <u>1/4</u> , Sec. <u>10 T 3 R 1</u> <u>4</u> miles <u>West</u> , of <u>Florence</u> (distance) (direction) (Nearest Town)	Blue clay		135
	Shell + shale		158
	Lime + shaly lime rock		192
(3) Topography: <input checked="" type="checkbox"/> (Hilly) <input type="checkbox"/> (Flat) <input type="checkbox"/> (Level)	Blue clay		257
	Blue shale + shaly sand		262
(4) Purpose of Well: <u>Home</u> (Domestic Irrigation Municipal, Industrial, Other)	sand + shaly shale		272
	med sand		304


Information upon completion of well:

- (1) Diameter 2 inches.
- (2) Total Depth 304 feet.
- (3) Water Level 28 feet below top of ground.
- (4) Cased to 194, Size 2"
- (5) Screen: Size 2", Length 10ft
- (6) Were any formations sealed against pollution?
_____ yes, no.

If YES depth of formation _____
Why _____

Drillers Remarks: _____

CODED

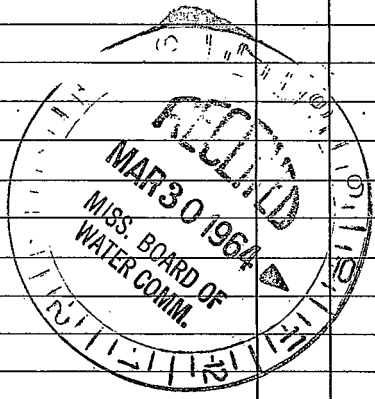

(Use Back Side)

Well No.

Retain this copy for your office files.

1937

1937