

MES
T1

~~MISSISSIPPI~~ MISSISSIPPI GEOLOGICAL SURVEY

6-18-65 T 42 WATER WELL DRILLERS LOG

Date: 6-18-65, Driller: James McNeese, County: Hinds

(Name)

(1) Owner of Land: Rose Sweatt
(Name)

Florence Miss
(Address)

(2) Location: NE 1/4, NW 1/4, Sec 3, 3^N R 1^E
1/2 miles East of Florence
(distance) (direction) (Nearest Town)

(3) Topography: (Hilly) (Flat) (Level)

(4) Purpose of Well: Domestic
(Domestic Irrigation, Municipal, Industrial, Other)

| Description & Color of Material Sand, Clay, Red Clay, Silt | Thickness Feet | Depth Feet |
|---|-------------------|---------------|
| Surface soil | 10 | 10 |
| SAND | 86 | 96 |
| SAND-sh str | 9 | 105 |
| Grey shale | 38 | 143 |
| SAND | 2 | 145 |
| Grey shale | 86 | 231 |
| Rock sh str | 31 | 262 |
| Grey sdy sh | 34 | 296 |
| Grey shale | 63 | 359 |

CODED

Information upon completion of well:

(1) Diameter 2 inches.

(2) Total Depth 359 feet.

(3) Water Level 147 feet below top of ground.

(4) Cased to 241, Size

(5) Screen: Size NONE, Length

(6) Were any formations sealed against pollution?
yes, no.


If YES depth of formation

Why

Drillers Remarks:

12 ft 2" 242
No screen

CODED

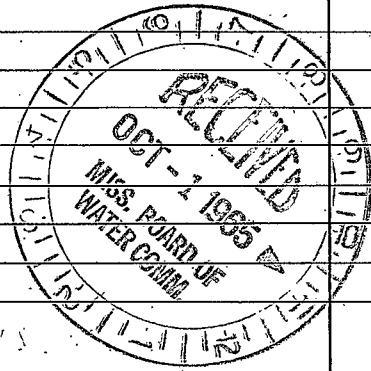

(Use Back Side)

Well No.

1944

1944