

**RANKIN**  
**T 45**  
**2-3-75**

MISSISSIPPI  
 BOARD OF WATER COMMISSIONERS  
 416 North State Street  
 Jackson, Mississippi 39201

CODED

WATER WELL DRILLERS LOG

2/3/75 19 R. E. Thompson Rankin  
 date well completed firm name county well located


LANDOWNER:	description of formations encountered	from	to
<u>Frank Monahan</u>	<u>top soil</u>	0	5
(mailing address)	<u>loam clay</u>	5	20
WELL LOCATION:	<u>see CODED</u>	20	20
sec <u>33</u> T <u>3</u> (N) R <u>1</u> (E) <u>7</u> miles <u>S/W</u> <u>Thomson</u> (distance) (direction) (nearest town)	<u>clay</u>	40	50
WELL PURPOSE: <u>Private</u> (home, irrigation, municipal, industrial)	<u>sand</u>	50	70
WELL COMPLETION DATA:	<u>Blue clay</u>	70	140
(1) diameter (inches) <u>2"</u>	<u>sand</u>	140	120
(2) total depth (feet) <u>330'</u>	<u>Blue clay</u>	170	220
(3) static water level (feet) <u>80'</u> below top of ground.	<u>sand</u>	220	224
(4) casing <u>Plastic, 164'</u> (material) (depth)	<u>Blue clay</u>	274	330
<u>2"</u> If telescope see back. (size)			
(5) screen <u>6"</u> , <u>164'</u> (length) (depth to top)			
<u>008</u> , <u>Plastic</u> (size) (material)			
(6) pump: <u>his pump</u> (HP) (yield gpm)			
(type power)			
(7) electric log (yes or no)			
(organization running log)			
(8) how well bottom plugged			
DRILLERS REMARKS:			
<u>his pump was not</u> <u>any good. this</u> <u>is the only well in</u>			

RECEIVED  
 APR 21 1975

MISS. BD. OF WATER COMMISSIONERS

If well telescopes please sketch and show depths.

GROUND LEVEL

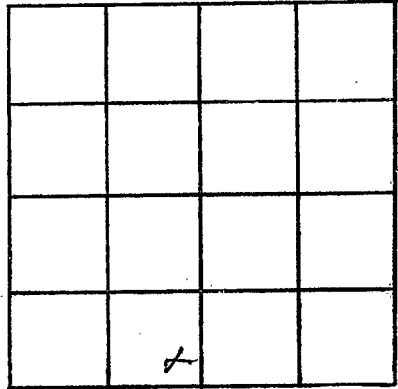

SECTION 33

Please indicate well location X.

ADDITIONAL INFORMATION

If more than one screen, show locations of each on sketch.

1