

Rarkin  
T 46

6/9/76  
Elev #424

6/9/76  
date well completed

MISSISSIPPI  
BOARD OF WATER COMMISSIONERS  
416 North State Street  
Jackson, Mississippi 39201

CODED

WATER WELL DRILLERS LOG

13T

#0222

19

R.E. Thompson  
firm name

Rarkin  
county well located

LANDOWNER:

Joseph Brinson  
Henry Miss.  
(mailing address)

description of formations encountered

from

to

|             |     |     |
|-------------|-----|-----|
| Sand shale  | 0   | 40  |
| Blue clay   | 40  | 202 |
| Sand & clay | 202 | 224 |
| Sand.       | 224 | 249 |

WELL LOCATION:

sec 28 T 3 N R 1 E  
8 miles SW of Florence  
(distance) (direction) (nearest town)

WELL PURPOSE: House  
(home, irrigation, municipal, industrial)

WELL COMPLETION DATA:

- (1) diameter (inches) 4" x 2"
- (2) total depth (feet) 249'
- (3) static water level (feet) 80 below top of ground.
- (4) casing Plastic 4" 190' (material) 2" 180' (depth) 230'  
(size) If telescope see back.
- (5) screen 10' (length) 230' (depth to top)  
.008 (size) Plastic (material)
- (6) pump 3/4 (HP) 15 (yield gpm)  
Sub. (type power)
- (7) electric log yes (yes or no)  
R.E. Thompson (organization running log)
- (8) how well bottom plugged Not done

CODED



RECEIVED  
JUL - 8 1976

MISS. BD. OF WATER COMMISSIONERS

DRILLERS REMARKS:

If well telescopes please sketch and show depths.

GROUND LEVEL

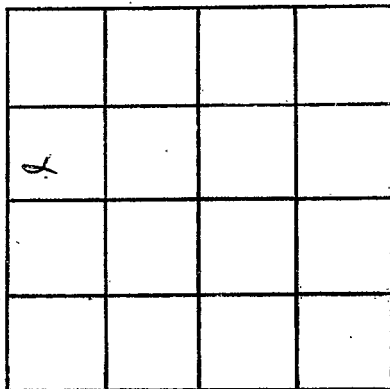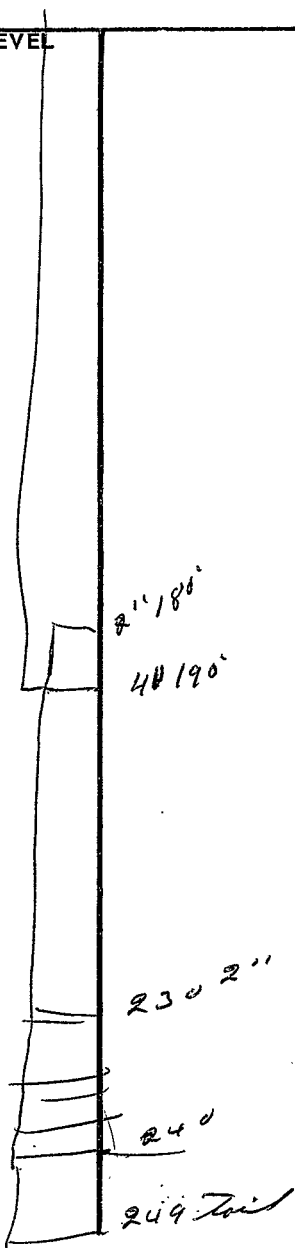

SECTION 28

Please indicate well location X.

ADDITIONAL INFORMATION

A series of horizontal lines for additional information.

If more than one screen, show locations of each on sketch.