

RANKIN

T48

8-21-79

89-1-19 date well completed

MISSISSIPPI BOARD OF WATER COMMISSIONERS 416 North State Street Jackson, Mississippi 39201

WATER WELL DRILLERS LOG

CODED

part of

27 Burnin Waterwell Prod firm name

county well located

LANDOWNER:

T.R. LAIRD

(mailing address)

WELL LOCATION:

sec 25 T 3 N R 1 E S W miles (distance) of (direction) of (nearest town)

WELL PURPOSE:

(home, irrigation, municipal, industrial)

WELL COMPLETION DATA:

- (1) diameter (inches)
(2) total depth (feet)
(3) static water level (feet) below/above top of ground.
(4) casing (material) (depth) (size) if telescope see back.
(5) screen (length) (depth to top) (size) (material)
(6) pump (HP) (yield gpm) (type power)
(7) electric log (yes or no) (organization running log)
(8) how well bottom plugged

description of formations encountered

from

to


CODED

DRILLERS REMARKS:

Rec'd 10-3-79

If well telescopes please sketch and show depths.

GROUND LEVEL

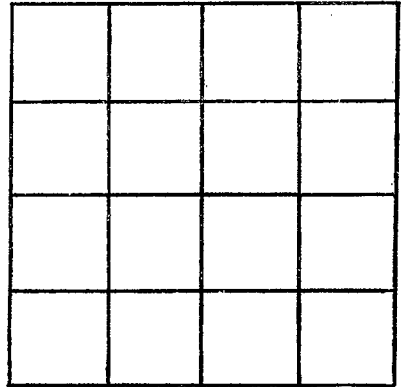

SECTION _____

Please indicate well location X.

ADDITIONAL INFORMATION

If more than one screen, show locations of each on sketch.