

RANKIN
T50
11/9/82

MISSISSIPPI
BOARD OF WATER COMMISSIONERS
416 North State Street
Jackson, Mississippi 39201

CODED

WATER WELL DRILLERS LOG

11/9 1982 Layne-Central Company Rankin
date well completed firm name county well located

LANDOWNER: Southwest
RANKIN W.A. % Engineering
Services
(mailing address)

description of formations encountered	from	to
RED CLAY	0	15
SAND	15	20
CLAY	20	146
ROCK	146	151
HARD CLAY	151	185
SAND	185	200
ROCK	200	202
SAND	202	243
CLAY	243	245

WELL LOCATION:
sec 36 T 30 N S R 1 E W
miles _____ of _____
(distance) (direction) (nearest town)

WELL PURPOSE: Water Association
(home, irrigation, municipal, industrial)

- WELL COMPLETION DATA:
- (1) diameter (inches) 16"
 - (2) total depth (feet) 257'
 - (3) static water level (feet) 130' below above top of ground.
 - (4) casing Steel, 185',
(material) (depth)
16"
(size) if telescope see back.
 - (5) screen 57'10", 185'
(length) (depth to top)
10", Stainless Steel
(size) (material)
 - (6) pump 20 300
(HP) (yield gpm)
Electric
(type power)
 - (7) electric log yes
(yes or no)
Ms. Geo. Survey
(organization running log)
 - (8) how well bottom plugged Stainless Steel Plate

185'
57'
130'

DEPT. OF NATURAL RESOURCES
BUREAU OF LAND & WATER RESOURCES

DEC 14 1982


RECEIVED

DRILLERS REMARKS:

(4)

If well telescopes please sketch and show depths.

GROUND LEVEL

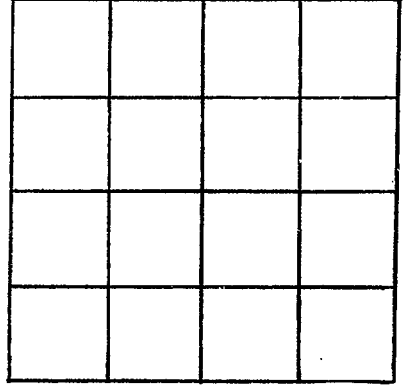

SECTION _____

Please indicate well location X.

ADDITIONAL INFORMATION

If more than one screen, show locations of each on sketch.