

RANKIN
T 2000
12-04-78

MISSISSIPPI
BOARD OF WATER COMMISSIONERS
416 North State Street
Jackson, Mississippi 39201

WATER WELL DRILLERS LOG

12-4-78 19 Gunner Water Well Srv Rankin
date well completed firm name county well located

LANDOWNER:
Rogers, S
(mailing address)

description of formations encountered	from	to
SAND	0	40
CLAY	40	145
SANDY CLAY	145	150
CLAY	150	155
SAND	155	165

WELL LOCATION:
sec. 5 T 2 N R 1 E
miles of (distance) (direction) (nearest town)

WELL PURPOSE:
(home, irrigation, municipal, industrial)

WELL COMPLETION DATA:

(1) diameter (inches) 4

(2) total depth (feet) 165

(3) static water level (feet) 150 below top of ground

(4) casing PVC 145 (material) (depth)

4 (size) if telescope see back.

(5) screen 20 145 (length) (depth to top)

4 PVC (size) (material)

(6) pump 3/4 15 (HP) (yield gpm)

(type power)

(7) electric log NO (yes or no)

(organization running log)


(8) how well bottom plugged BCU

DRILLERS REMARKS:

RECEIVED
DEC 13 1978

If well telescopes please sketch and show depths.

GROUND LEVEL

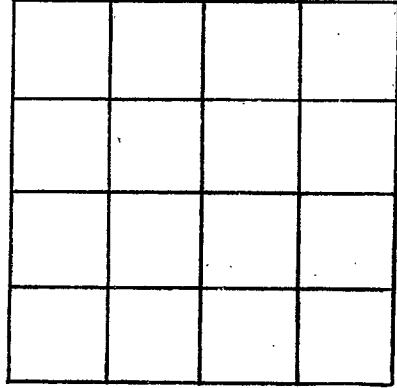

SECTION _____

Please indicate well location X.

ADDITIONAL INFORMATION

If more than one screen, show locations of each on sketch.