

MISSISSIPPI BOARD OF WATER COMMISSIONERS

RANKIN  
U 18  
11-5-64

Elect 206 MGS  
WATER WELL DRILLERS LOG

CODED  
MGS  
55  
Hinds

Date: 11-5, 1964, Driller: James McNeess County Hinds  
(Name)

(1) Owner of Land: Geo. Hadden  
(Name)  
FLORENCE MISS  
(Address)  
(2) Location: SW 1/4, SE 1/4, Sec. 6, T 3 N, R 2 E  
6 miles SE of Florence  
(distance) (direction) (Nearest Town)  
(3) Topography:  (Hilly)  (Flat)  (Level)  
(4) Purpose of Well: Domestic  
(Domestic Irrigation, Municipal, Industrial, Other)

Description & Color of Materials Sand, Clay, Red Clay, Shell, etc.	Thick- ness Feet	Depth Feet
SURFACE SOIL	10	10
SAND	70	80
Blue shale	120	200
Blue shale Fossils	7	207
ROCK - sh STKs	33	240
Grey sdy sh	80	320
Grey shale	135	455
ROCK	1	456
Grey shale	324	780
Grey sdy sh	22	802
Grey shale	18	820
Grey sdy sh	28	848
Grey sdy sh sd shells	43	891
Grey sh	88	979
Grey sdy sh	12	991
SAND	130	1121
2 JTS 5"	42	1
1-9" x 5" swedge	1	
18 JTS 4"	359	
32 JTS 2 1/2"	677	
40" OOB SSS	40	
1 JT 2 1/2 BPV	18	
	1138	
TID	1121	
h28 2nd 924	17	

Information upon completion of well:

(1) Diameter 9" x 7 1/2 inches.

(2) Total Depth 1121 feet.

(3) Water Level 160 feet below top of ground.

(4) Cased to 1073, Size 4x2 1/2


(5) Screen: Size 2 1/2 OOB, Length 40

(6) Were any formations sealed against pollution?  
yes,  no.

If YES depth of formation \_\_\_\_\_

Why \_\_\_\_\_

Drillers Remarks: \_\_\_\_\_

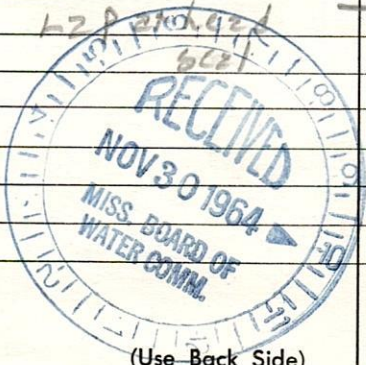

Well No.