

Rankin
U32
2-66

MISSISSIPPI BOARD OF WATER COMMISSIONERS

Electrical Log by M.G.S.
WATER WELL DRILLERS LOG

M65
U4

Rankin
County

Date: 2-14, 1966, Driller: James M^e Nees County: Rankin
(Name)


Location correct
ELV 275'

(1) Owner of Land: Capitol 66 Oil Co
(Name)
Box 2839 West Jackson
(Address) STATION
(2) Location: SE 1/4, SE 1/4, Sec. 11 T2R2E
SE SE
1 miles NW of STER
(distance) (direction) (Nearest Town)
(3) Topography: (Hilly) (Flat) (Level)
(4) Purpose of Well: Domestic
(Domestic Irrigation
Municipal, Industrial, Other)

Description & Color of Materials Sand, Clay, Red Clay, Shell, etc.	Thick- ness Feet	Depth Feet
Surface soil	5	5
Clay	25	30
Blue shale	38	68
Shale & ROCK STRKS	47	115
SAND	2	117
Blue shale	13	130
Rock-sh strks	7	137
SAND	3	140
SAND-sh. strks	10	150
SAND & shale	5	155
SAND	8	163
Grey shale	100	263
SAND	5	268
Grey shale	45	313
Rock sh strks	30	343
SAND-shale	7	350
Grey sh	12	362
SAND	6	368
Grey sh Lignite	11	379
Grey sdy sh	41	420
16 Jts 4"		295
1-7" x 2 1/2" swedge		1
4 Jts 2 1/2"		68
1-2 1/2" .007 ss screen		3 64
		10
1-2 1/2" Nipple &		3 74
B. P. V.		2
		3 76

Information upon completion of well:

(1) Diameter 4 x 2 1/2 inches.
(2) Total Depth 420 feet.
(3) Water Level 130 feet below top of ground.
(4) Cased to 364', Size 4" x 2 1/2"
(5) Screen: Size .007 2 1/2", Length 10
(6) Were any formations sealed against pollution?
yes, no.
If YES depth of formation
Why
Drillers Remarks:
Water has
slight color

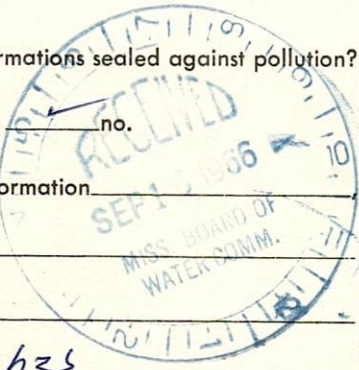

(Use Back Side)

Well No.