

RANKIN  
U35  
log # 376

MISSISSIPPI  
BOARD OF WATER COMMISSIONERS  
416 North State Street  
Jackson, Mississippi 39201

CODED

WATER WELL DRILLERS LOG

3/19/1973 19 W. E. Thompson Rankin  
date well completed firm name county well located

LANDOWNER:

A. V. Summerville

(mailing address)

WELL LOCATION:

sec. 11 T 3 (N) R 2 (E)  
S W  
2 miles 3/4 of Star  
(distance) (direction) (nearest town)

WELL PURPOSE:

(home, irrigation, municipal, industrial)

WELL COMPLETION DATA:

- (1) diameter (inches) 2"  
(2) total depth (feet) 360'  
(3) static water level (feet) 73 below above  
top of ground.  
(4) casing 250'  
(material) (depth)  
2"  
(size) If telescope see back.  
(5) screen open hole  
(length) (depth to top)  
(size) (material)

- (6) pump 1 (HP) 7 (yield gpm)

J. J.  
(type power)

- (7) electric log yes  
(yes or no)

M. J. S.  
(organization running log)

- (8) how well bottom plugged open

description of formations encountered

from to

<u>sandy</u>	<u>0</u>	<u>20</u>
<u>Blue clay</u>	<u>20</u>	<u>98</u>
<u>fine sand</u>	<u>98</u>	<u>110</u>
<u>Blue clay</u>	<u>110</u>	<u>260</u>
<u>Limestone</u>	<u>260</u>	<u>300</u>
<u>sand &amp; shells</u>	<u>300</u>	<u>310</u>
<u>Blue clay</u>	<u>310</u>	<u>334</u>
<u>sand</u>	<u>334</u>	<u>340</u>
<u>clay</u>	<u>340</u>	<u>360</u>
<u>sand</u>	<u>360</u>	<u>360</u>


CODED

DRILLERS REMARKS:

This well is at same site as another well drilled for the home. other well now 499. Wayne 6/21/73

If well telescopes please  
sketch and show depths.

GROUND LEVEL

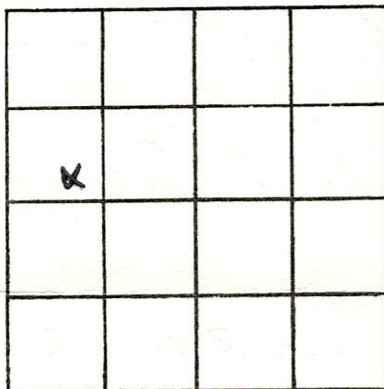

SECTION 11

Please indicate well location X.

ADDITIONAL INFORMATION

If more than one screen,  
show locations of each on sketch.