

Rankin
 U37
 3-69

MISSISSIPPI
 BOARD OF WATER COMMISSIONERS
 416 North State Street
 Jackson, Mississippi 39201

CODED

WATER WELL DRILLERS LOG

March 5 1969 J. E. Thompson Rankin
 date well completed firm name county well located

LANDOWNER:	description of formations encountered	from	to
Bill Cooper			
(mailing address)			
WELL LOCATION:			
sec. 30 T 3 N R 2 E			
5 1/2 miles S of Florence			
(distance) (direction) (nearest town)			
WELL PURPOSE: home			
(home, irrigation, municipal, industrial)			
WELL COMPLETION DATA:			
(1) diameter (inches) 2"			
(2) total depth (feet) 275'			
(3) static water level (feet) 74 below top of ground.			
(4) casing Plastic 180' (material) (depth)			
2" if telescope see back. (size)			
(5) screen (length) (depth to top)			
(size) (material)			
(6) pump 1 (HP) 6 (yield gpm)			
(type power)			
(7) electric log YES (yes or no)			
(organization running log)			
(8) how well bottom plugged			
DRILLERS REMARKS:			
Well will flow			
30 N. P. 70.			

113 118
 118 119
 119 136
 136 156
 156 208
 208 228


CODED

MAR 7 2 1969

MISS. BO. OF WATER COMM.

If well telescopes please sketch and show depths.

GROUND LEVEL

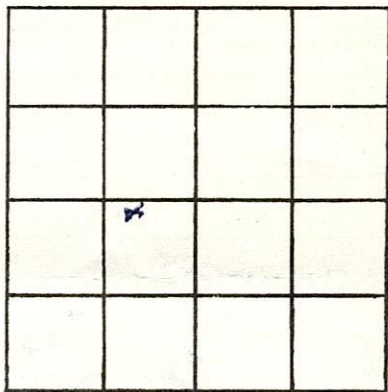

SECTION 30

Please indicate well location X.

ADDITIONAL INFORMATION

If more than one screen,
show locations of each on sketch.