

MISSISSIPPI
BOARD OF WATER COMMISSIONERS
416 North State Street
Jackson, Mississippi 39201

WATER WELL DRILLERS LOG

Rankin
U 48
9-28-69


Sept 28 1969 Thompson Well Co Rankin
date well completed firm name county well located

LANDOWNER:	description of formations encountered	from	to
<u>Eddie Myers</u> <u>Holmes Miss.</u> (mailing address)	<u>sandy clay</u>	<u>0</u>	<u>20</u>
WELL LOCATION: sec. <u>3</u> T. <u>3</u> N R. <u>2</u> E <u>3</u> miles <u>S/E</u> of <u>Holmes</u> (distance) (direction) (nearest town)	<u>Blue clay</u>	<u>20</u>	<u>150</u>
WELL PURPOSE: <u>drinking</u> (home, irrigation, municipal, industrial)	<u>sand</u>	<u>150</u>	<u>171</u>
WELL COMPLETION DATA: (1) diameter (inches) <u>2"</u> (2) total depth (feet) <u>271'</u> (3) static water level (feet) <u>70</u> <u>below</u> <u>above</u> top of ground. (4) casing <u>Plastic 260'</u> (material) (depth) <u>2"</u> if telescope see back. (size) (5) screen <u>10'</u> <u>260'</u> (length) (depth to top) <u>2"</u> <u>Plastic</u> (size) (material) (6) pump <u>3/4</u> <u>6</u> (HP) (yield gpm) <u>Jet</u> (type power) (7) electric log <u>no</u> (yes or no) <u></u> (organization running log) (8) how well bottom plugged <u>11/27/68</u>			
DRILLERS REMARKS:			

OCT 21 1969
MISS. DEPT. OF
WATER CONTROL

If well telescopes please sketch and show depths.

GROUND LEVEL

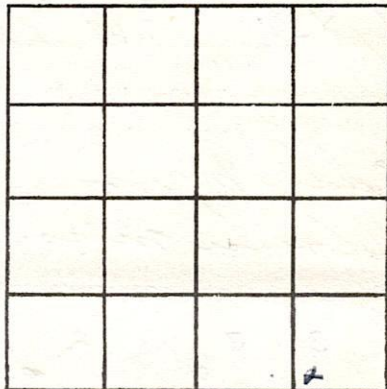

SECTION 3

Please indicate well location X.

ADDITIONAL INFORMATION

If more than one screen,
show locations of each on sketch.