

RANKIN

U 50

10-5-70

MISSISSIPPI BOARD OF WATER COMMISSIONERS 416 North State Street Jackson, Mississippi 39201

WATER WELL DRILLERS LOG

CODED

Oct 5

date well completed

1970 K. E. Thayer

firm name

Rankin

county well located

LANDOWNER:	description of formations encountered	from	to
<i>Ernie Morris</i>			
<i>R. B. Schaner Mrs.</i> (mailing address)	<i>clay</i>	<i>10</i>	<i>20</i>
WELL LOCATION: <i>34</i> sec <i>27</i> T. <i>32</i> N. R. <i>2</i> E. <i>W</i>	<i>hard sand</i>	<i>20</i>	<i>57</i>
<i>3</i> miles <i>S/W</i> of <i>Stev.</i>	<i>Below clay</i>	<i>57</i>	<i>250</i>
(distance) (direction) (nearest town)	<i>hard</i>	<i>250</i>	<i>270</i>
WELL PURPOSE: <i>home</i>	<i>Below clay</i>	<i>270</i>	<i>301</i>
(home, irrigation, municipal, industrial)			
WELL COMPLETION DATA:			
(1) diameter (inches) <i>2"</i>			
(2) total depth (feet) <i>301'</i>			
(3) static water level (feet) <i>110</i> below top of ground.			
(4) casing <i>Plastic, 260'</i> (material) (depth)			
<i>2"</i> (size) if telescope see back.			
(5) screen <i>10'</i> , <i>260'</i> (length) (depth to top)			
<i>2"</i> , <i>Plastic</i> (size) (material)			
(6) pump <i>1 1/2</i> , <i>5'</i> (HP) (yield gpm)			
<i>Jet</i> (type power)			
(7) electric log <i>yes</i> (yes or no)			
<i>M. H. A.</i> (organization running log)			
(8) how well bottom plugged <i>4/4</i>			
DRILLERS REMARKS:			


CODED

OCT 14 1970

MISS. BD. OF WATER COM.

If well telescopes please sketch and show depths.

GROUND LEVEL

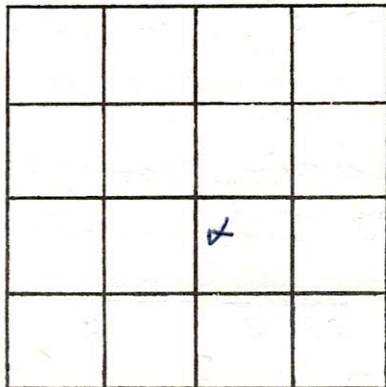

SECTION 27

Please indicate well location X.

ADDITIONAL INFORMATION

If more than one screen,
show locations of each on sketch.