

U 64
RANKIN
7-9-73

MISSISSIPPI
BOARD OF WATER COMMISSIONERS
416 North State Street
Jackson, Mississippi 39201

CODED

WATER WELL DRILLERS LOG


July 9 1973 K. E. Thompson Rankin
date well completed firm name county well located

LANDOWNER:	description of formations encountered	from	to
T. Williams			
(mailing address)	Gray Clay	10	30
WELL LOCATION:	Rock	30	32
sec. 11 T 3 N R 2 E	Blue Clay	32	133
2 1/2 miles N of Star	Sand	133	167
(distance) (direction) (nearest town)			
WELL PURPOSE: (home, irrigation, municipal, industrial)			
WELL COMPLETION DATA:			
(1) diameter (inches) 2"			
(2) total depth (feet) 167			
(3) static water level (feet) 66 below top of ground.			
(4) casing Plasted 152 (material) (depth)			
2" (size) If telescope see back.			
(5) screen 10' 152 (length) (depth to top)			
2" Plasted (size) (material)			
(6) pump 1 7 (HP) (yield gpm)			
42 (type power)			
(7) electric log no (yes or no)			
(organization running log)			
(8) how well bottom plugged			
DRILLERS REMARKS:			

AUG 13 1973

If well telescopes please sketch and show depths.

GROUND LEVEL

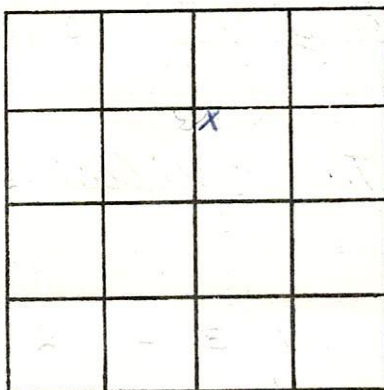

SECTION 11

Please indicate well location X.

ADDITIONAL INFORMATION

If more than one screen,
show locations of each on sketch.