

Rankin
U 68
8-20-75
E log # 414

MISSISSIPPI
 BOARD OF WATER COMMISSIONERS
 416 North State Street
 Jackson, Mississippi 39201

WATER WELL DRILLERS LOG

CODED

8/20 1975 N. E. Thompson Rankin
 date well completed firm name county well located

LANDOWNER: <u>E. West Jones</u>	description of formations encountered	from	to
<u>Rt. 3 Box 381</u> <u>Florence</u> (mailing address)			
WELL LOCATION: sec. <u>7</u> T. <u>3</u> N. R. <u>2</u> E. ^{13T} <u>3</u> <u>5</u> <u>W</u> <u>W</u> <u>Florence</u> (distance) (direction) (nearest town)	<u>top soil.</u>	<u>0</u>	<u>2</u>
WELL PURPOSE: <u>Home</u> (home, irrigation, municipal, industrial)	<u>unshaly.</u>	<u>2</u>	<u>40</u>
WELL COMPLETION DATA: (1) diameter (inches) <u>4 X 2</u>	<u>blue clay.</u>	<u>40</u>	<u>192</u>
(2) total depth (feet) <u>360</u>	<u>lime stone.</u>	<u>192</u>	<u>210</u>
(3) static water level (feet) <u>125</u> below above top of ground.	<u>clay.</u>	<u>210</u>	<u>216</u>
(4) casing <u>Plastic 216'</u> (material) (depth), <u>4 X 2</u> If telescope see back. (size)	<u>unsh.</u>	<u>216</u>	<u>226</u>
(5) screen <u>10'</u> , <u>216</u> (length) (depth to top) <u>008</u> , <u>Plastic</u> (size) (material)	<u>clay.</u>	<u>226</u>	<u>360</u>
(6) pump <u>1/2</u> (HP) <u>4</u> (yield gpm) <u>Sub.</u> (type power)			
(7) electric log <u>yes</u> (yes or no) <u>M. S. S.</u> (organization running log)			
(8) how well bottom plugged <u>5/8" galv.</u>			

RECEIVED
 SEP - 8 1975

MISS. BD. OF WATER COMM.

DRILLERS REMARKS:
Well made in
mint spring sand.

If well telescopes please sketch and show depths.

GROUND LEVEL

4" casing


2" casing

192

216

224

no tail

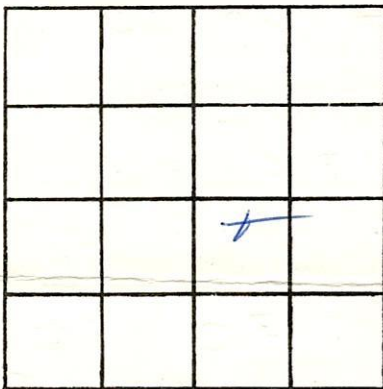

SECTION 7

Please indicate well location X.

ADDITIONAL INFORMATION

Lined area for additional information.

If more than one screen, show locations of each on sketch.