

RANKIN
U76
5-5-80
F log # 500

MISSISSIPPI
BOARD OF WATER COMMISSIONERS
 416 North State Street
 Jackson, Mississippi 39201

CODED

WATER WELL DRILLERS LOG

May 5 19*80* *R.M. "Bud" Cresswell* *RANKIN*
 date well completed firm name county well located

LANDOWNER:
Shell Oil Company
Houston, Texas
 (mailing address)

description of formations encountered	from to	
<i>Clay-shale</i>	<i>0</i>	<i>110</i>
<i>Sand</i>	<i>110</i>	<i>140</i>
<i>Sand-sticks Sand</i>	<i>140</i>	<i>450</i>
<i>Rock</i>	<i>450</i>	<i>500</i>
<i>Clay</i>	<i>500</i>	<i>960</i>
<i>Sand-sticks Sand</i>	<i>960</i>	<i>1180</i>
<i>Sand</i>	<i>1180</i>	<i>1230</i>

WELL LOCATION:
 sec. *26* T *3* N R *2* E
3 miles *S-W* of *STAR*
 (distance) (direction) (nearest town)

WELL PURPOSE: *INDUSTRIAL*
 (home, irrigation, municipal, industrial)

- WELL COMPLETION DATA:**
- (1) diameter (inches) *6*
 - (2) total depth (feet) *1230*
 - (3) static water level (feet) *295* below above top of ground.
 - (4) casing *Steel* *1190*
 (material) (depth)
6 if telescope see back.
 (size)
 - (5) screen *40* *1190*
 (length) (depth to top)
4 *Stainless*
 (size) (material)
 - (6) pump *20* *100*
 (HP) (yield gpm)
0
 (type power)
 - (7) electric log *yes*
 (yes or no)
State
 (organization running log)

(8) how well bottom plugged
Sand Shakes

DRILLERS REMARKS:


DEPT. OF NATURAL RESOURCES
 BUREAU OF LAND & WATER RESOURCES

MAY 28 1980
RECEIVED

(X)

If well telescopes please sketch and show depths.

GROUND LEVEL

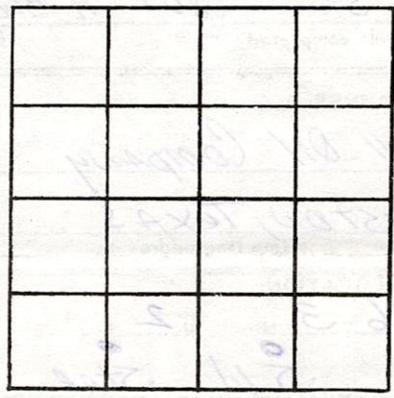

SECTION _____

Please indicate well location X.

ADDITIONAL INFORMATION

A series of horizontal lines for recording additional information, starting below the 'ADDITIONAL INFORMATION' header and extending to the bottom of the page.

If more than one screen, show locations of each on sketch.