

RANKIN
 U83
 5-13-81
 Elog # 519

MISSISSIPPI
 BOARD OF WATER COMMISSIONERS
 416 North State Street
 Jackson, Mississippi 39201

CODED

WATER WELL DRILLERS LOG

Rankin

5-13-81 date well completed 1981 firm name county well located

LANDOWNER: Bob Ridgeway

description of formations encountered	from	to
SAND	0	100
CLAY	100	235
SAND	235	275

(mailing address)

WELL LOCATION:
 sec 35 T 3 N R 2 E
 S W

(distance) miles (direction) of (nearest town)

WELL PURPOSE:
 (home, irrigation, municipal, industrial)

WELL COMPLETION DATA:

- (1) diameter (inches) 4"
- (2) total depth (feet) 275
- (3) static water level (feet) 160 below top of ground
- (4) casing PVC 235 (material), (depth)
 4" (size) If telescope see back.
- (5) screen 40 235 (length), (depth to top)
 4" (size), PVC (material)
- (6) pump 3/4 10 (HP), (yield gpm)

(type power)

(7) electric log (yes-or-no)
 MB (organization running log)


(8) how well bottom plugged 130V



DRILLERS REMARKS:

If well telescopes please sketch and show depths.

GROUND LEVEL

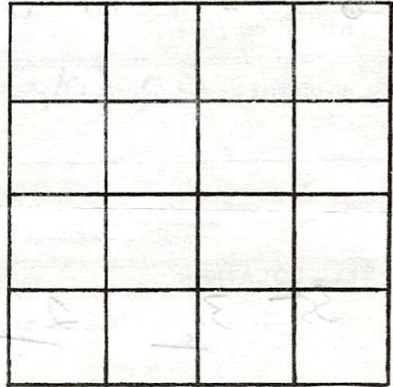

SECTION _____

Please indicate well location X.

ADDITIONAL INFORMATION



than one screen,
locations of each on sketch.