

RANKIN
U84
9-30-82

MISSISSIPPI
BOARD OF WATER COMMISSIONERS
416 North State Street
Jackson, Mississippi 39201

CODED

WATER WELL DRILLERS LOG

9-30-1982 date well completed
Gunn wellser firm name
RANKIN county well located

LANDOWNER:
Gerald Martin
(mailing address)

description of formations encountered	from	to
CLAY SAND	0	260
	260	290

WELL LOCATION:
sec. 14 T. 3 N. R. 2 E
S W
miles of
(distance) (direction) (nearest town)

WELL PURPOSE:
(home, irrigation, municipal, industrial)

- WELL COMPLETION DATA:
- (1) diameter (inches) 4"
 - (2) total depth (feet) 350
 - (3) static water level (feet) 300 below top of ground
 - (4) casing PVC 270 (material) (depth)
4" (size) if telescope see back.
 - (5) screen 20 270 (length) (depth to top)
4" (size) PVC (material)
 - (6) pump 1 15 (HP) (yield gpm)
- (type power)
- (7) electric log (yes or no)
- (organization running log)
- (8) how well bottom plugged 1300

CODED

DEPT. OF NATURAL RESOURCES
BUREAU OF LAND & WATER RESOURCES


NOV 30 1982

RECEIVED

DRILLERS REMARKS:

If well telescopes please sketch and show depths.

GROUND LEVEL

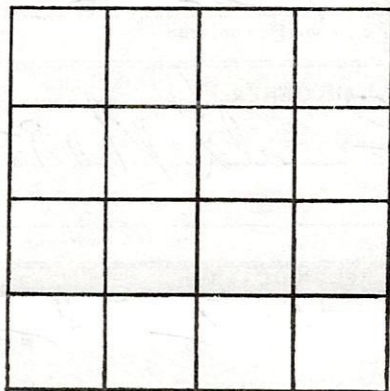

SECTION _____

Please indicate well location X.

ADDITIONAL INFORMATION

If more than one screen, show locations of each on sketch.