

RANKIN
U 86
11/4/82

MISSISSIPPI
BOARD OF WATER COMMISSIONERS
416 North State Street
Jackson, Mississippi 39201

CODED ✓

WATER WELL DRILLERS LOG

11/4/82 19 Jack Gains Water Well Rankin
date well completed firm name county well located

LANDOWNER:	description of formations encountered	from	to
<u>Horace Whitfield</u>	<u>Clay</u>	<u>1</u>	<u>80</u>
<u>Florence, Ms</u> (mailing address)	<u>Sand</u>	<u>81</u>	<u>140</u>
<u>WELL LOCATION:</u>	<u>Clay</u>	<u>141</u>	<u>160</u>
sec. <u>36</u> T. <u>3</u> N R. <u>2</u> E	<u>Rock</u>	<u>161</u>	<u>180</u>
<u>8</u> miles <u>SE</u> of <u>Stone</u>	<u>Shale</u>	<u>181</u>	<u>260</u>
(distance) (direction) (nearest town)	<u>Sand</u>	<u>261</u>	<u>282</u>
<u>WELL PURPOSE:</u> <u>Home</u> (home, irrigation, municipal, industrial)			
<u>WELL COMPLETION DATA:</u>			
(1) diameter (inches) <u>4"</u>			
(2) total depth (feet) <u>282</u>			
(3) static water level (feet) <u>180</u> below top of ground.			
(4) casing <u>Pvc</u> , <u>260'</u> (material) (depth)			
<u>4"</u> if telescope see back. (size)			
(5) screen <u>20'</u> , <u>260'</u> (length) (depth to top)			
<u>4"</u> , <u>Pvc</u> (size) (material)			
(6) pump <u>3/4</u> , <u>10</u> (HP) (yield gpm)			
<u>electricity</u> (type power)			
(7) electric log <u>Yes</u> (yes or no)			
<u>Ms. Bureau of Geology</u> (organization running log)			
(8) how well bottom plugged <u>Backwash valve</u>			
DRILLERS REMARKS:			

CODED


DEPT. OF NATURAL RESOURCES
BUREAU OF LAND & WATER RESOURCES

DEC - 7 1982

RECEIVED

If well telescopes please sketch and show depths.

GROUND LEVEL

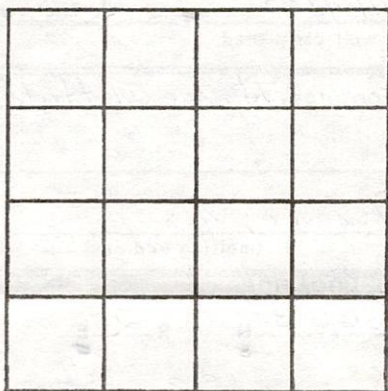

SECTION _____

Please indicate well location X.

ADDITIONAL INFORMATION

If more than one screen,
show locations of each on sketch.