

MISSISSIPPI DEPARTMENT OF NATURAL RESOURCES

Bureau of Land and Water Resources

Southport Mall

P.O. Box 10631

Jackson, Mississippi 39209

WATER WELL DRILLERS LOG

CODED Rankin

RANKIN
U87
3/22/83

3/22/83 date well completed 1983 Jack Guinn water firm name Well Ser. Hinds county well located

LANDOWNER: J. T. Dale

| description of formations encountered | from | to |
|---------------------------------------|------|-----|
| top soil | 0 | 30 |
| Sand material | 30 | 60 |
| Brown clay | 60 | 100 |
| Shell | 100 | 150 |
| Blue clay | 150 | 200 |
| Rock & sand | 200 | 260 |

(mailing address)

WELL LOCATION:
sec. 8 T 3 N R 2 E
3 miles E of Florence
(distance) (direction) (nearest town)

WELL PURPOSE: Home
(home, irrigation, municipal, industrial)

WELL COMPLETION DATA:

- (1) diameter (inches) 4 in.
- (2) total depth (feet) 389 ft.
- (3) static water level (feet) 180 below top of ground.
- (4) casing P.V.C. 210 ft.
(material) (depth)
4 in. if telescope see back.
(size)
- (5) screen 12 ft. 228
(length) (depth to top)
4 in. P.V.C.
(size) (material)
- (6) pump 1/2 7
(HP) (yield gpm)
Electric
(type power)
- (7) electric log yes
(yes or no)
m.s.d.
(organizing running log)
- (8) how well bottom plugged Back wash valve

CODED

DEPT. OF NATURAL RESOURCES
BUREAU OF LAND & WATER RESOURCES


MAY 3 1983

RECEIVED

DRILLERS REMARKS:

If well telescopes please sketch and show depths.

GROUND LEVEL

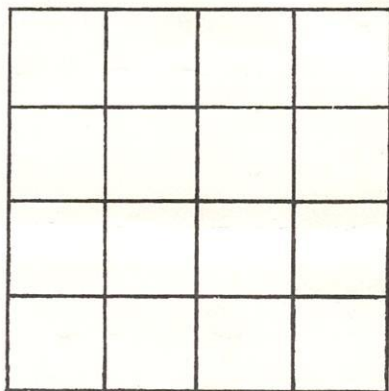

SECTION _____

Please indicate well location X.

ADDITIONAL INFORMATION

If more than one screen, show locations of each on sketch.