

U88 Elog 555  
Rankin  
8-16-84

MISSISSIPPI  
BOARD OF WATER COMMISSIONERS  
416 North State Street  
Jackson, Mississippi 39201

WATER WELL DRILLERS LOG

CODE

8-16  
date well completed

1984

Gunnwell  
firm name

Ranking  
county well located

LANDOWNER: Crowley  
RANDY CARRAN

(mailing address)

WELL LOCATION:

sec 27 T 3 N R 2 E  
S W

miles of  
(distance) (direction) (nearest town)

WELL PURPOSE:

(home, irrigation, municipal, industrial)

WELL COMPLETION DATA:

- diameter (inches) 4"
- total depth (feet) 240
- static water level (feet) 180" below above top of ground.
- casing (material) PUC, (depth) 220  
4" if telescope see back.  
(size)
- screen (length) 20', (depth to top) 220  
4' (size) PUC (material)
- pump 1 (HP) 10 (yield gpm)

(type power)

- electric log (yes or no) MS  
(organization running log)

- how well bottom plugged B W

DRILLERS REMARKS:

description of formations encountered

from

to

CLAY  
SAND  
CLAY  
SAND

0 40  
40 55  
55 220  
220 240


CODE

-289 on E log

Red 210  
1-1-85

If well telescopes please sketch and show depths.

GROUND LEVEL

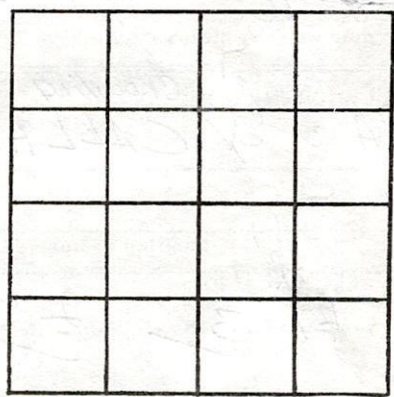

SECTION \_\_\_\_\_

Please indicate well location X.

ADDITIONAL INFORMATION

A series of horizontal lines for recording additional information, located below the 'ADDITIONAL INFORMATION' header.

If more than one screen, show locations of each on sketch.