

U-96

RANKIN

6-13-74

Elog # 393

6-13-1974

1974

MISSISSIPPI BOARD OF WATER COMMISSIONERS
416 North State Street
Jackson, Mississippi 39201

CODED

WATER WELL DRILLERS LOG

JACK GUINN

RANKIN

date well completed

firm name

county well located

LANDOWNER:	description of formations encountered	from	to
HENRY FOSTER	CLAY	1	60
(mailing address)	SAND	60	90
WELL LOCATION:	CLAY	90	260
sec. <u>6</u> T. <u>3</u> N. R. <u>2</u> E.	SAND	260	273
(distance) _____ miles _____ of _____ (direction) _____ (nearest town)			
WELL PURPOSE: (home, irrigation, municipal, industrial)			
WELL COMPLETION DATA:			
(1) diameter (inches) <u>4"</u>			
(2) total depth (feet) <u>273</u>			
(3) static water level (feet) <u>9</u> below above top of ground.			
(4) casing <u>JIC</u> , <u>260</u> , (material), (depth), <u>4"</u> (size) If telescope see back.			
(5) screen <u>13</u> , <u>260</u> (length), (depth to top) <u>2</u> , <u>SS</u> (size), (material)			
(6) pump <u>1</u> , <u>10</u> (HP), (yield gpm) <u>MPL</u> (type power)			
(7) electric log <u>yes</u> (yes or no) <u>USGS</u> (organization running log)			
(8) how well bottom plugged <u>BWU</u>			
DRILLERS REMARKS:			


CODED

RECEIVED
SEP 16 1974

MISS. DD. OF W...

If well telescopes please sketch and show depths.

GROUND LEVEL

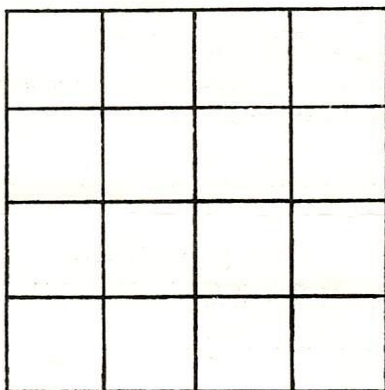

SECTION _____

Please indicate well location X.

ADDITIONAL INFORMATION

A series of horizontal lines for entering additional information, starting below the 'ADDITIONAL INFORMATION' header and extending to the bottom of the page.

If more than one screen, show locations of each on sketch.