

Rankin
U 2001

MISSISSIPPI
BOARD OF WATER COMMISSIONERS
416 North State Street
Jackson, Mississippi 39201

CODED

WATER WELL DRILLERS LOG

11/9/82 19 Jack Quinn Water Well Serv. Rankin
date well completed firm name county well located

LANDOWNER: <u>Joseph To Hale</u>	description of formations encountered	from	to
<u>Florence, Ms.</u> (mailing address)			
WELL LOCATION: sec. <u>8</u> T. <u>3</u> N R. <u>2</u> E <u>3 1/2</u> miles <u>S</u> of <u>Florence</u> (distance) (direction) (nearest town)	<u>Sandy Shale</u>	<u>91</u>	<u>210</u>
WELL PURPOSE: <u>Home</u> (home, irrigation, municipal, industrial)	<u>Sand</u>	<u>211</u>	<u>260</u>
WELL COMPLETION DATA: (1) diameter (inches) <u>4"</u>	<u>Clay</u>	<u>261</u>	<u>290</u>
(2) total depth (feet) <u>478'</u>	<u>Sand</u>	<u>291</u>	<u>340</u>
(3) static water level (feet) <u>128</u> below above top of ground.	<u>Shaly Sand</u>	<u>341</u>	<u>400</u>
(4) casing <u>PVC</u> , <u>310'</u> (material) (depth)	<u>Clay</u>	<u>401</u>	<u>478</u>
<u>4"</u> If telescope see back. (size)			
(5) screen <u>20</u> , <u>310'</u> (length) (depth to top)			
<u>4"</u> , <u>PVC</u> (size) (material)			
(6) pump <u>1</u> , <u>10</u> (HP) (yield gpm)			
<u>electricity</u> (type power)			
(7) electric log <u>Yes</u> (yes or no)			
<u>Bureau of Geology</u> (organization running log)			
(8) how well bottom plugged <u>Backwash valve</u>			
DRILLERS REMARKS:			

CODED


DEPT. OF NATURAL RESOURCES
BUREAU OF LAND & WATER RESOURCES

DEC - 7 1982

RECEIVED

If well telescopes please sketch and show depths.

GROUND LEVEL

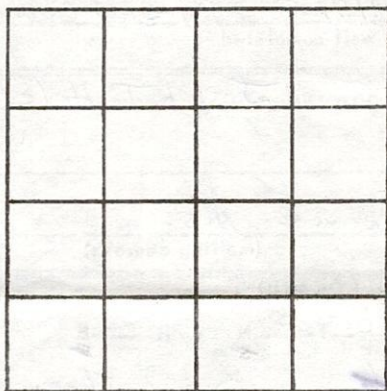

SECTION _____

Please indicate well location X.

ADDITIONAL INFORMATION

If more than one screen, show locations of each on sketch.