

RANKIN
 U71
 9-16-76
 E log #428

MISSISSIPPI
 BOARD OF WATER COMMISSIONERS
 416 North State Street
 Jackson, Mississippi 39201

CODED

WATER WELL DRILLERS LOG

9/18/76 19 B. E. Thompson Rankin
 date well completed firm name county well located

LANDOWNER:	description of formations encountered	from	to
<u>Lodge owner</u>			
(mailing address)	<u>Blue clay.</u>	<u>80</u>	<u>90</u>
WELL LOCATION:	<u>Blue clay.</u>	<u>90</u>	<u>295</u>
sec. <u>19</u> T <u>3</u> N S R <u>3</u> E W	<u>hard.</u>	<u>295</u>	<u>320</u>
<u>1</u> miles <u>S/E</u> of <u>Star</u>			
(distance) (direction) (nearest town)			
WELL PURPOSE: <u>Home</u>			
(home, irrigation, municipal, industrial)			
WELL COMPLETION DATA:			
(1) diameter (inches) <u>4x2</u>			
(2) total depth (feet) <u>320'</u>			
(3) static water level (feet) <u>245'</u> ^{below} <u>above</u> top of ground.			
(4) casing <u>Plastic, 300'</u>			
(material) (depth)			
<u>4x2</u> If telescope see back.			
(size)			
(5) screen <u>15'</u> , <u>300'</u>			
(length) (depth to top)			
<u>1/4</u> , <u>S.S.</u>			
(size) (material)			
(6) pump <u>1</u> <u>10</u>			
(HP) (yield gpm)			
<u>Sub.</u>			
(type power)			
(7) electric log <u>yes</u>			
(yes or no)			
(organization running log)			
(8) how well bottom plugged <u>m.b.d.</u>			
DRILLERS REMARKS:			

CODED

RECEIVED
 OCT 19 1976

MISS. BD. OF WATER COMM.

If well telescopes please sketch and show depths.


GROUND LEVEL

4x2 pack
279'

4" casing
bit @ 280'

15" x 1/4"
s.s.
-008

4' tail

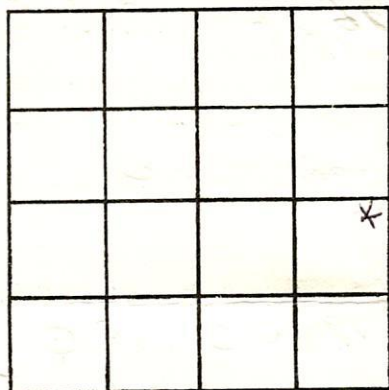

SECTION 19

Please indicate well location X.

ADDITIONAL INFORMATION

If more than one screen,
show locations of each on sketch.