

Rankin
U 14
6-24-69
M.S. & U.S.G.S.
6/24/69

MISSISSIPPI
 BOARD OF WATER COMMISSIONERS
 416 North State Street
 Jackson, Mississippi 39201

WATER WELL DRILLERS LOG **CODED**

19 W.E. Thompson Well Dr. Rankin
 date well completed firm name county well located

LANDOWNER: A.C. Moore

description of formations encountered from to

(mailing address)

WELL LOCATION:
 sec. 35 T. 3 N R. 2 E
3 miles S/4 of Star
 (distance) (direction) (nearest town)

WELL PURPOSE: Home
 (home, irrigation, municipal, industrial)

WELL COMPLETION DATA:

- (1) diameter (inches) 2"
- (2) total depth (feet) 360'
- (3) static water level (feet) 130' below top of ground.
- (4) casing Plastic (material) (depth) 2' if telescope see back. (size)
- (5) screen Open (length) (depth to top) (size) (material)
- (6) pump (HP) (yield gpm)
- (7) electric log no (yes or no)
- (organization running log)
- (8) how well bottom plugged open

<u>sand</u>	<u>111</u>	<u>112</u>
<u>6' Brown clay</u>		
<u>sand</u>	<u>144</u>	<u>152</u>
<u>Very fine sand</u>	<u>152</u>	<u>212</u>
<u>Clay</u>	<u>212</u>	<u>170</u>
<u>sand</u>	<u>CODED</u>	<u>170</u> <u>172</u>
<u>clay</u>	<u>172</u>	<u>270</u>
<u>sand</u>	<u>270</u>	<u>270</u>
<u>clay</u>	<u>275</u>	<u>320</u>
<u>sand</u>	<u>320</u>	<u>325</u>
<u>clay</u>	<u>325</u>	<u>327</u>


DATE 7-1969

DRILLERS REMARKS: Well to water
at 190/202
fine water

MISS. BD. OF
 WATER CONTROL

If well telescopes please sketch and show depths.

GROUND LEVEL

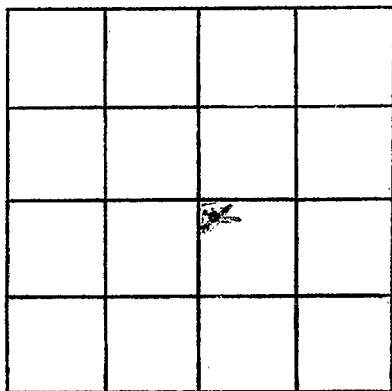

SECTION 30

Please indicate well location X.

ADDITIONAL INFORMATION

If more than one screen,
show locations of each on sketch.