

Rankin
 V16
 4-67
 Elec Log
 4-25-67
 date well completed

MISSISSIPPI BOARD OF WATER COMMISSIONERS
 416 North State Street
 Jackson, Mississippi 39201

CODED

MGS
 V3

WATER WELL DRILLERS LOG

James D McNeas Rankin
 firm name county well located


LANDOWNER: DOCK LOFFLIN
 STAR MISS
 (mailing address)

description of formations encountered	from	to
SURFACE SOIL	0	10
Blue shale	10	120
Grey sd4 sh	120	157
SAND	157	180
Grey sh	180	205

WELL LOCATION:
 sec. 7 T 3 N R 3 E
 2 miles NE of STAR
 (distance) (direction) (nearest town)

WELL PURPOSE: HOME
 (home, irrigation, municipal, industrial)

- WELL COMPLETION DATA:
- diameter (inches) 4" x 2"
 - total depth (feet) 205
 - static water level (feet) 105 below top of ground
 - casing steel (material), (depth)
 4" x 2" (size) if telescope see back.
 - screen 10' 166' (length) (depth to top)
 2" stainless steel (size) (material)
 - pump 1 12 (HP) (yield gpm)
 Elec (type power)
 - electric log yes (yes or no)
 M.G.S. (organization running log)
 - how well bottom plugged mud

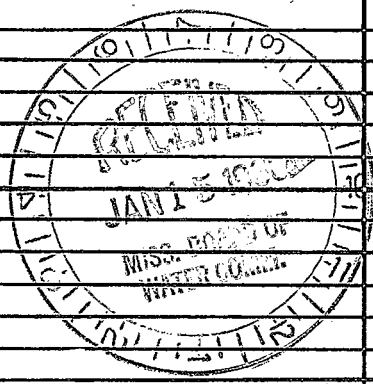

DRILLERS REMARKS:
 Water clear

