

MISSISSIPPI BOARD OF WATER COMMISSIONERS

RANKIN
U18
11-5-64

Elect Log M G S
WATER WELL DRILLERS LOG

CODED
HINDS

Date: 11-5, 1964, Driller: James McNeas County HINDS
(Name)

(1) Owner of Land: Geo. Hadden
(Name)
Florence Miss
(Address)

(2) Location: SW 1/4, SE NE 1/4, Sec. 6, T 3 N, R 2E
6 miles SE, of Florence
(distance) (direction) (Nearest Town)

(3) Topography: (Hilly) (Flat) (Level)

(4) Purpose of Well: Domestic
(Domestic Irrigation, Municipal, Industrial, Other)

Description & Color of Materials Sand, Clay, Red Clay, Shell, etc.	Thickness Feet	Depth Feet
SURFACE SOIL	10	10
SAND	90	80
Blue shale	120	200
Blue shale Fossils	7	207
ROCK - sh STRS	33	240
Grey sdy sh	80	320
Grey shale	135	455
ROCK	1	456
Grey shale	324	780
Grey sdy sh	22	802
Grey shale	18	820
Grey sdy sh	28	848
Grey sdy sh sd shells	43	891
Grey sh	88	979
Grey sdy sh	12	991
SAND	130	1121
2 1/2" 5"	42	1
1-9" x 5" blades	1	
18 1/2" 4"	359	
32 1/2" 2 1/2"	677	
40" 008 355	40	
1 1/2" 2 1/2" BPV	12	
	1138	
	1121	
	17	

Information upon completion of well:

(1) Diameter 9" x 2 1/2" inches.

(2) Total Depth 1121 feet.

(3) Water Level 160 feet below top of ground.

(4) Cased to 1073, Size 4" x 2 1/2"


(5) Screen: Size 2 1/2" 008, Length 40

(6) Were any formations sealed against pollution?
no

If YES depth of formation _____

Why _____

Drillers Remarks: _____

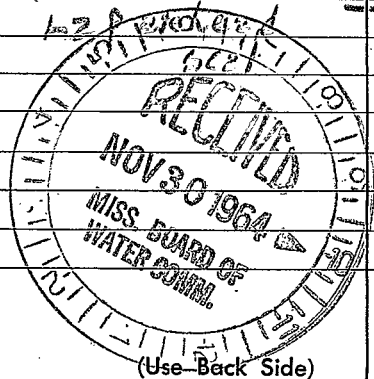

Well No.

Retain this copy for your office files.

