

**RANKIN**  
**U 24**  
**8-22-67**

MISSISSIPPI  
 BOARD OF WATER COMMISSIONERS  
 416 North State Street  
 Jackson, Mississippi 39201

ELOG # 174

**CODED**

WATER WELL DRILLERS LOG

8/22  
 date well completed

1967 H. E. Thompson  
 firm name

Rankin  
 county well located

LANDOWNER:  
 Joe Byrd  
 Florence Miss.  
 (mailing address)

WELL LOCATION:  
 sec. 5 T 3 N R 2 E  
 2 miles S 1/2 E Florence  
 (distance) (direction) (nearest town)

WELL PURPOSE: Home  
 (home, irrigation, municipal, industrial)

- WELL COMPLETION DATA:
- diameter (inches) 2"
  - total depth (feet) 263'
  - static water level (feet) 130' below top of ground.
  - casing (material) 2" (depth) 220'  
 2" (size) if telescope see back.
  - screen open (length) (depth to top)  
 (size) (material)
  - pump 1 1/2 (HP) 5 (yield gpm)  
 Jet (type power)
  - electric log yes (yes or no)  
 M. H. S. (organization running log)
  - how well bottom plugged Open

description of formations encountered	from	to
Surface	0	10
hard clay	10	35
Blue clay	35	110
fine sand	110	130
Blue clay	130	230
sand	230	236
Blue clay	236	263

**CODED**


FEB 24 1971

MISS. Bd. OF  
 WATER COMM.

DRILLERS REMARKS:

If well telescopes please sketch and show depths.

GROUND LEVEL

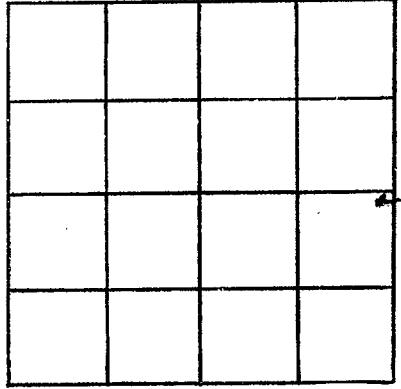

SECTION 5

Please indicate well location X.

ADDITIONAL INFORMATION

If more than one screen, show locations of each on sketch.