

**RANKIN**  
 U 26  
 7-8-68

MISSISSIPPI  
 BOARD OF WATER COMMISSIONERS  
 416 North State Street  
 Jackson, Mississippi 39201

E LOG #197

**CODED**

WATER WELL DRILLERS LOG

7/8 1968 *H. E. Thompson* Rankine  
 date well completed firm name county well located

LANDOWNER:  
*Edna Mae Phyllis*  
*Silvener Miss.*  
 (mailing address)

description of formations encountered	from	to
Surface	0	5
Red clay	5	50
fine sand	50	60
Blue clay	60	134
Pea gravel sand	134	160
Blue clay	160	284
sand	284	292
Blue clay	292	304

WELL LOCATION:  
 sec 10 T 3 N R 2 E  
 3 miles S/E of Silvener  
 (distance) (direction) (nearest town)

WELL PURPOSE:  
 (home, irrigation, municipal, industrial)

- WELL COMPLETION DATA:
- (1) diameter (inches) 2"
  - (2) total depth (feet) 304'
  - (3) static water level (feet) 120' below top of ground.
  - (4) casing Sales, 189'  
 (material) (depth)  
2" If telescope see back.  
 (size)
  - (5) screen open hole  
 (length) (depth to top)  
 (size) (material)
  - (6) pump 1 1/2 3 1/2  
 (HP) (yield gpm)  
Jet  
 (type power)
  - (7) electric log yes  
 (yes or no)  
M. H. S.  
 (organization running log)
  - (8) how well bottom plugged open

**CODED**

FEB 24 1971


DRILLERS REMARKS:

MISS. BD. OF  
 WATER COM.



If well telescopes please sketch and show depths.

GROUND LEVEL

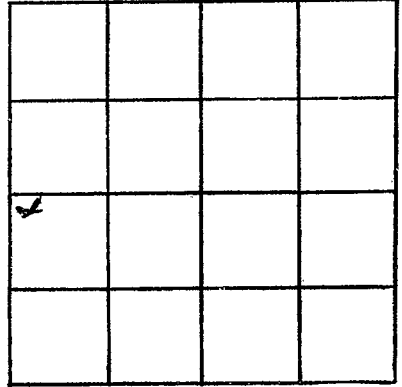

SECTION 10

Please indicate well location X.

ADDITIONAL INFORMATION

If more than one screen,  
show locations of each on sketch.