

RANKIN, Miss.

U-27 White?

5-17-61

WATER WELL D

Date: 5/17, 1961, Driller: Rankin

(Name U. 300

(1) Owner of Land: W.E. Comers (Name)

Rt 2 Florenet (Address)

(2) Location: NE 1/4, NW 1/4, Sec. 30 T3R2

6 miles South of Florenet (distance) (direction) (Nearest Town)

(3) Topography: (Hilly) (Flat) (Level)

(4) Purpose of Well: (Domestic Irrigation Municipal, Industrial, Other)

Information upon completion of well:

(1) Diameter 2 inches.

(2) Total Depth 52 feet.

(3) Water Level 61 feet below top of ground.

(4) Cased to 147, Size 2"

(5) Screen: Size 1 1/4, Length 4 ft.

(6) Were any formations sealed against pollution? yes, no.

If YES depth of formation

Why


Drillers Remarks:

Description & Color of Materials Sand, Clay, Red Clay, Shell, etc.

Red Clay	10	10
White Shell	20	30
Blue Shell	115	145
Sand	7	152

CODED

CODED

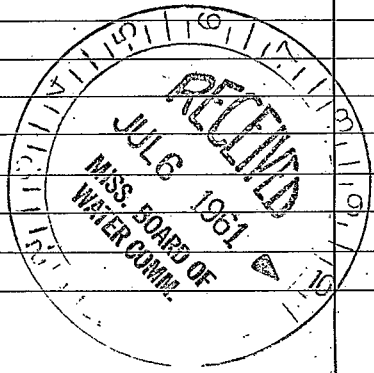

(Use Back Side)

Well No.

