

Rankin  
 U 29  
 12-66

MISSISSIPPI BOARD OF WATER COMMISSIONERS

WATER WELL DRILLERS LOG

**CODED**

Date: Dec 2 19 66, Driller: W. G. Butler County St. James  
 (When well drilled) (Name) (Where well is located)

(1) Owner of Land: Eddie S. M. Minton  
 (Name)  
Florence, Pt. Miss.  
 (Address)

(2) Location: N 1/4, SE 1/4, Sec. 6 T3R2  
2 1/2 miles S of Florence  
 (distance) (direction) (Nearest Town)

(3) Topography:  (Hilly)  (Flat)  (Level)

(4) Purpose of Well: Domestic  
 (Domestic Irrigation  
 Municipal, Industrial, Other)

Description & Color of Materials Sand, Clay, Red Clay, Shell, etc.	Thick- ness Feet	Depth Feet
Red Clay	5	5
SAND & CHALK	5	10
CHALK	10	20
SAND CHALK	5	25
ROCK CHALK	5	30
SAND CHALK	5	35
SAND	12	47

Information upon completion of well:

(1) Diameter 2" inches.

(2) Total Depth 47 feet.

(3) Water Level 30 feet below top of ground.


(4) Cased to 42, Size 2".

(5) Screen: Size 2, Length 5'.

(6) Were any formations sealed against pollution?  
 \_\_\_\_\_ yes,  no.

YES depth of formation \_\_\_\_\_  
 /hy \_\_\_\_\_

Drillers Remarks: \_\_\_\_\_  
 Yield in gpm: 10 gal -  
 Size pump: 1/2 H.P.  
 Type power: Electric

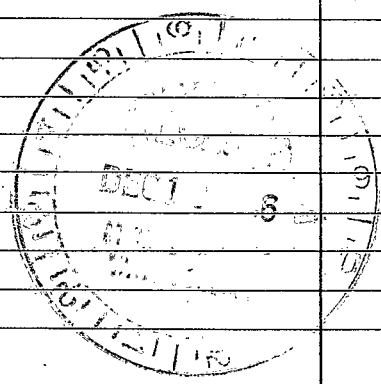

[The page contains extremely faint and illegible text, likely bleed-through from the reverse side of the document. No specific words or phrases can be discerned.]