

CODED

MISSISSIPPI
BOARD OF WATER COMMISSIONERS
416 North State Street
Jackson, Mississippi 39201

WATER WELL DRILLERS LOG

RANKIN
W 31
4-68

april 4 1968 W. G. Butler Rankin
date well completed firm name county well located

LANDOWNER:

William Guich
Florence, Miss.
(mailing address)

description of formations encountered

from to

Clay & Chalk
Sand 0 15
15-65

WELL LOCATION:

sec 6 T 3 N R 2 E
S W
2 miles S of Florence
(distance) (direction) (nearest town)

WELL PURPOSE:

Home
(home, irrigation, municipal, industrial)


WELL COMPLETION DATA:

- (1) diameter (inches) 2"
- (2) total depth (feet) 65
- (3) static water level (feet) 40 ~~above~~ below top of ground.
- (4) casing 9311, 60'
(material) (depth)
2" (size) if telescope see back.
- (5) screen 5' 55'
(length) (depth to top)
2" 55'
(size) (material)
- (6) pump 3/4 10
(HP) (yield gpm)
Electric
(type power)
- (7) electric log No
(yes or no)

(organization running log)


(8) how well bottom plugged 2" B.W.K.

DRILLERS REMARKS:

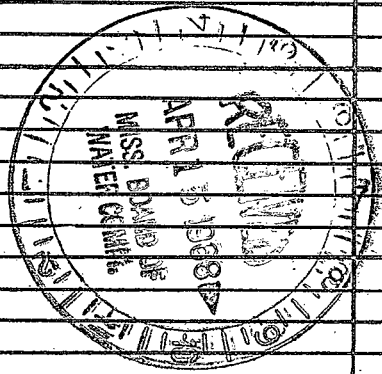

If well telescopes please sketch and show depths.

GROUND LEVEL

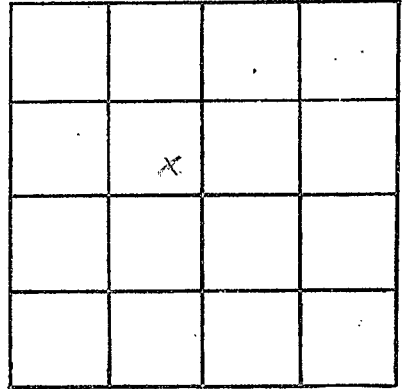

SECTION 6

Please indicate well location X.

ADDITIONAL INFORMATION

Lined area for additional information.

If more than one screen, show locations of each on sketch.