

RANKIN  
U32  
2-66

MISSISSIPPI BOARD OF WATER COMMISSIONERS

Electrical Log by M.G.S.  
WATER WELL DRILLERS LOG

U32

~~Rankin~~  
Rankin

Date: 2-14, 1966, Driller: James M<sup>e</sup> Nees County Rankin

(Name)

Location correct  
275'

(1) Owner of Land: Capital 66 Oil. Co  
(Name)  
Box 2829 West Jackson  
(Address) STATION

(2) Location: SE  $\frac{1}{4}$ , SE  $\frac{1}{4}$ , Sec. 11 T 2 R 2 E  
1 miles SE of SE  
(distance) (direction) (Nearest Town)

(3) Topography: Flat  
(Hilly) (Flat) (Level)

(4) Purpose of Well: Domestic  
(Domestic Irrigation  
Municipal, Industrial, Other)

Description & Color of Materials Sand, Clay, Red Clay, Shell, etc.	Thick-ness Feet	Depth Feet
Surface soil	5	5
Clay	25	30
Blue shale	38	68
Shale & Rock strks	47	115
Sand	2	117
Blue shale	13	130
Rock-sh strks	7	137
Sand	3	140
Sand-sh. strks	10	150
Sand & shale	5	155
Sand	8	163
Grey shale	100	263
Sand	5	268
Grey shale	45	313
Rock sh strks	30	343
Sand-shale	7	350
Grey sh	12	362
Sand	6	368
Grey sh Lignite	11	379
Grey sdy sh	41	420
16 Jts 4"	295	
1-4" x 2 1/2" swedge	1	
4 Jts 2 1/2"	68	
1-2 1/2" .007 ss screen	364	
	10	
1-2 1/4" Nipple & B.P.V.	374	
	2	
	376	

Information upon completion of well:

(1) Diameter: 4" x 2 1/2" inches.

(2) Total Depth: 420 feet.

(3) Water Level: 130 feet below top of ground.

(4) Cased to: 364', Size: 4" x 2 1/2"


(5) Screen: Size .007 2 1/2", Length 10

(6) Were any formations sealed against pollution?  
 yes,  no.

If YES depth of formation \_\_\_\_\_

Why \_\_\_\_\_

Drillers Remarks:  
Water has slight color

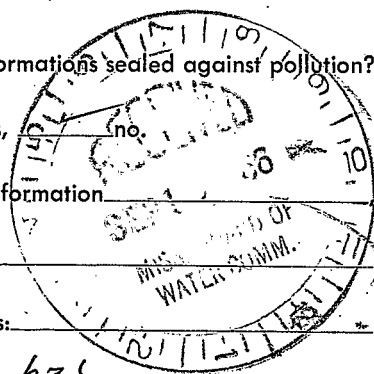

(Use Back Side)

Well No.

1948