

RANKIN

MISSISSIPPI BOARD OF WATER COMMISSIONERS

U 34
9-19-60

WATER WELL DRILLERS LOG

U 300

Date: Sept 19, 1960, Driller: Stokes R. Gordon County Rankin
(Name)

(1) Owner of Land: W.F. Hillon
(Name)

Star, Miss
(Address)

(2) Location: $\frac{1}{4}$, $\frac{1}{4}$, Sec 13 T3R2
_____ miles _____ of _____
(distance) (direction) (Nearest Town)

(3) Topography: ✓
(Hilly) (Flat) (Level)

(4) Purpose of Well: Domestic
(Domestic Irrigation
Municipal, Industrial, Other)

Description & Color of Materials Sand, Clay, Red Clay, Shell, etc.	Thick- ness Feet	Depth Feet
<u>Multi color Clay</u>	<u>0</u>	<u>55</u>
<u>Sand</u>	<u>35</u>	<u>92</u>
<u>Blue Clay</u>	<u>92</u>	<u>210</u>
<u>Sdy Blue Clay</u>	<u>210</u>	<u>235</u>
<u>Sand</u>	<u>235</u>	<u>250</u>

Information upon completion of well:

(1) Diameter 2 inches.

(2) Total Depth 260 feet.

(3) Water Level 145 feet below top of ground.

(4) Cased to 234, Size 2"

(5) Screen: Size 1/2, Length 20'


(6) Were any formations sealed against pollution?

All yes, no.

If YES depth of formation _____

Why _____

Drillers Remarks: _____

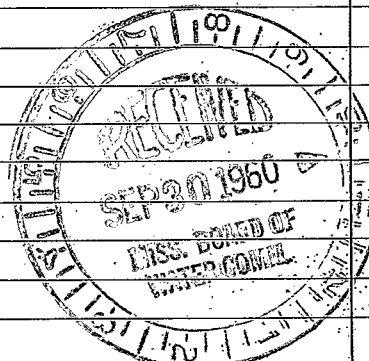

(Use Back Side)

Well No.

11

11

