

RANKIN
U35
3-29-73

MISSISSIPPI
 BOARD OF WATER COMMISSIONERS
 416 North State Street
 Jackson, Mississippi 39201

E log **CODEP**

WATER WELL DRILLERS LOG

3/29/73 date well completed W. E. Thompson firm name Rankin county well located

LANDOWNER: A. N. Lounsbury
 (mailing address)

WELL LOCATION:
 sec. 11 T. 30 N. R. 2 E
3 miles S of Talome
 (distance) (direction) (nearest town)

WELL PURPOSE: None
 (home, irrigation, municipal, industrial)

- WELL COMPLETION DATA:
- (1) diameter (inches) 2"
 - (2) total depth (feet) 365
 - (3) static water level (feet) 72 below above top of ground.
 - (4) casing Plastic 2.30' (material) (depth)
2" (size) if telescope see back.
 - (5) screen open hole (length) (depth to top)
 (size) (material)
 - (6) pump 1 (HP) 5 (yield gpm)
Sub (type power)
 - (7) electric log yes (yes or no)
M. H. S. (organization running log)
 - (8) how well bottom plugged open

description of formations encountered	from	to
<u>top soil</u>	<u>0</u>	<u>5</u>
<u>clay & sand</u>	<u>5</u>	<u>24</u>
<u>Blue clay</u>	<u>24</u>	<u>84</u>
<u>sand</u>	<u>84</u>	<u>110</u>
<u>Blue clay</u>	<u>110</u>	<u>260</u>
<u>Summit</u>	<u>260</u>	<u>310</u>
<u>clay</u>	<u>310</u>	<u>330</u>
<u>hard shells</u>	<u>330</u>	<u>365</u>


CODEP

APR 4 1973

DRILLERS REMARKS:

If well telescopes please sketch and show depths.

GROUND LEVEL

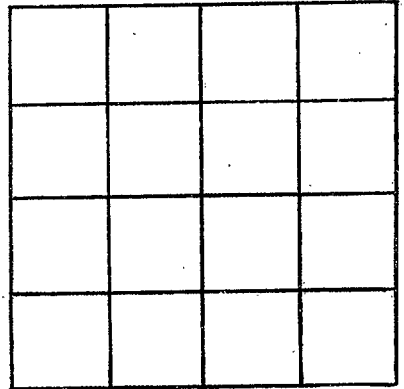

SECTION 11

Please indicate well location X.

ADDITIONAL INFORMATION

If more than one screen, show locations of each on sketch.