

Rankin.  
 B-69  
 U38

MISSISSIPPI  
 BOARD OF WATER COMMISSIONERS  
 416 North State Street  
 Jackson, Mississippi 39201

CODER

WATER WELL DRILLERS LOG

March 13 1969 W. C. Thomas Rankin  
 date well completed firm name county well located

LANDOWNER:  
Edlin Morgan  
 (mailing address)

WELL LOCATION:  
 sec. 14 T. 3 N. R. 2 E.  
2 miles W of Star  
 (distance) (direction) (nearest town)

WELL PURPOSE: Home  
 (home, irrigation, municipal, industrial)

- WELL COMPLETION DATA:
- (1) diameter (inches) 2 1/4
  - (2) total depth (feet) 336
  - (3) static water level (feet) 19 below above top of ground.
  - (4) casing Plastic 200' (material) (depth)  
2" If telescope see back. (size)
  - (5) screen Open hole (length) (depth to top)  
 (size) (material)
  - (6) pump 1 1/2 15 (HP) (yield gpm)  
Electric (type power)
  - (7) electric log YES (yes or no)  
M. A. S. (organization running log)
  - (8) how well bottom plugged Open


description of formations encountered	from	to
<u>Grey clay.</u>	<u>0</u>	<u>3</u>
<u>Blue clay.</u>	<u>20</u>	<u>40</u>
<u>Sand</u>	<u>40</u>	<u>44</u>
<u>Broken clay &amp; rock.</u>	<u>44</u>	<u>110</u>
<u>Shale &amp; clay.</u>	<u>110</u>	<u>170</u>
<u>Clay</u>	<u>170</u>	<u>318</u>
<u>CODED</u>		

DRILLERS REMARKS:  
...

MAKER 11 10 1969  
 MISS. BUREAU OF WATER CONTROL

If well telescopes please sketch and show depths.

GROUND LEVEL

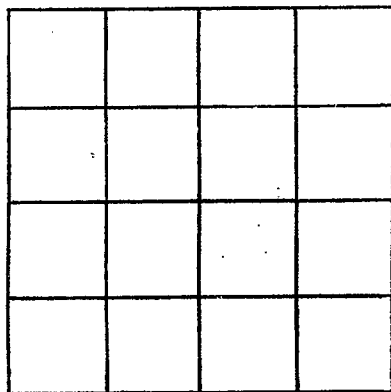

SECTION \_\_\_\_\_

Please indicate well location X.

ADDITIONAL INFORMATION

If more than one screen, show locations of each on sketch.