

RANKIN

U40

5-3-69

ELOG # 218

MISSISSIPPI BOARD OF WATER COMMISSIONERS
416 North State Street
Jackson, Mississippi 39201

CODED

WATER WELL DRILLERS LOG

5/3

date well completed

19

69 H. E. Thayer Banker

firm name

county well located

LANDOWNER:	description of formations encountered	from	to
<u>W. D. Banker</u>			
<u>Shannon Miss.</u> (mailing address)	<u>sandy clay</u>	<u>18</u>	<u>103</u>
WELL LOCATION: sec. <u>32</u> T <u>3</u> N R <u>2</u> E	<u>Rock</u>	<u>103</u>	<u>104</u>
<u>6</u> miles <u>S</u> of <u>Shannon</u>	<u>Blue clay</u>	<u>104</u>	<u>150</u>
(distance) (direction) (nearest town)	<u>Sand</u>	<u>150</u>	<u>215</u>
WELL PURPOSE: <u>home</u> (home, irrigation, municipal, industrial)			
WELL COMPLETION DATA:			
(1) diameter (inches) <u>2"</u>			
(2) total depth (feet) <u>215'</u>			
(3) static water level (feet) <u>95'</u> below top of ground.			
(4) casing <u>Galv</u> , <u>210'</u> (material) (depth)			
<u>2"</u> (size) If telescope see back.			
(5) screen <u>5"</u> , <u>210'</u> (length) (depth to top)			
<u>2 1/2</u> , <u>S.S.</u> (size) (material)			
(6) pump <u>2</u> <u>10</u> (HP) (yield gpm)			
<u>air</u> (type power)			
(7) electric log <u>yes</u> (yes or no)			
<u>M. N. S.</u> (organization running log)			
(8) how well bottom plugged <u>3/4</u>			
DRILLERS REMARKS:			


CODED

FEB 24 1971

MISS. DD. OF WATER COMMISSIONERS

If well telescopes please sketch and show depths.

GROUND LEVEL

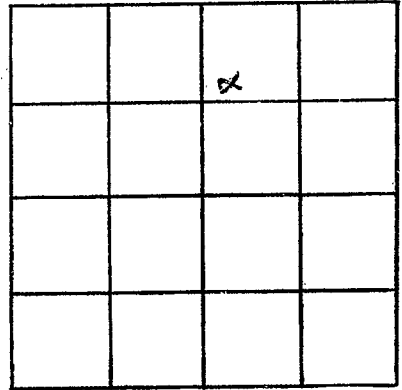

SECTION 32

Please indicate well location X.

ADDITIONAL INFORMATION

If more than one screen, show locations of each on sketch.