

Rankin  
U46  
8-21-69  
M-9. S.

MISSISSIPPI  
 BOARD OF WATER COMMISSIONERS  
 416 North State Street  
 Jackson, Mississippi 39201

CODED

WATER WELL DRILLERS LOG

Aug-21 1969 K. E. Thompson Well Rankin  
 date well completed firm name county well located

LANDOWNER:

Pat Harris.

description of formations encountered

from to

L. Lawrence Mads.  
 (mailing address)

Clay 0 50  
Sand 50 60

WELL LOCATION:

sec. 2 T 3 N R. 2 E  
3 miles 3/4 of Lumberton  
 (distance) (direction) (nearest town)

Sand & clay 60 100

WELL PURPOSE:  
 (home, irrigation, municipal, industrial)

Clay 100 140  
Sand 140 183

WELL COMPLETION DATA:

- (1) diameter (inches) 2"
- (2) total depth (feet) 183
- (3) static water level (feet) 75' below top of ground.
- (4) casing Aluminum 1 1/2"  
 (material) (depth)  
2 1/2" If telescope see back.  
 (size)
- (5) screen 20', 1 1/4"  
 (length) (depth to top)  
2", Aluminum  
 (size) (material)
- (6) pump 3/4 6  
 (HP) (yield gpm)  
 (type power) 20 Gal with air
- (7) electric log yes  
 (yes or no)  
M. S. A.  
 (organization running log)
- (8) how well bottom plugged B/W Val


SEP 11 1969

MISS. BD. OF WATER COMMISSIONERS

DRILLERS REMARKS:

If well telescopes please sketch and show depths.

GROUND LEVEL

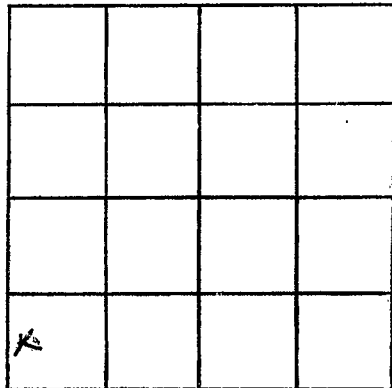

SECTION 2

Please indicate well location X.

ADDITIONAL INFORMATION

If more than one screen,  
show locations of each on sketch.