

RANKIN
 U 49
 8-3-70

MISSISSIPPI
 BOARD OF WATER COMMISSIONERS
 416 North State Street
 Jackson, Mississippi 39201

CODED

WATER WELL DRILLERS LOG

August 3 1970 K. E. Thompson Rankin
 date well completed firm name county well located

LANDOWNER:	description of formations encountered	from	to
Plantation Shores Lawrence Miss. (mailing address)			
WELL LOCATION:	Gray Clay & Rock	10	40
sec. 11 T 3 N R 2 E 2 miles W of Star (distance) (direction) (nearest town)	Blue Clay & Rock	40	146
WELL PURPOSE: Municipal (home, irrigation, municipal, industrial)	Sand	146	164
WELL COMPLETION DATA:	Blue clay	164	173

- (1) diameter (inches) 4"
- (2) total depth (feet) 173'
- (3) static water level (feet) 60 below top of ground.
- (4) casing Gal. Steel 148'
 (material) (depth)
 4" if telescope see back.
 (size)
- (5) screen 15' 148'
 (length) (depth to top)
 4" S.S. screen
 (size) (material)
- (6) pump 3 36
 (HP) (yield gpm)
 Sub.
 (type power)
- (7) electric log yes
 (yes or no)
 M. S. S.
 (organization running log)
- (8) how well bottom plugged *OK*


CODED

DRILLERS REMARKS:
 80° 6" Rhyolite set
 @ an Cemented

AL 4 1970

If well telescopes please sketch and show depths.

GROUND LEVEL

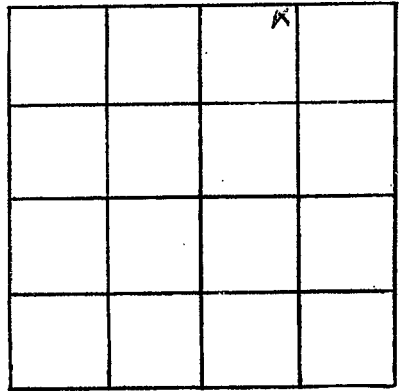

SECTION 11

Please indicate well location X.

ADDITIONAL INFORMATION

If more than one screen,
show locations of each on sketch.