

**RANKIN**  
 U 50  
 10-5-70

MISSISSIPPI  
 BOARD OF WATER COMMISSIONERS  
 416 North State Street  
 Jackson, Mississippi 39201

WATER WELL DRILLERS LOG

**CODED**

Oct 5 1970 *H. E. Thomas* Rankin  
 date well completed firm name county well located

LANDOWNER:	description of formations encountered	from	to
<i>E. Main Morris</i>			
<i>BB Schinner Mrs.</i> (mailing address)	<i>clay</i>	10	20
WELL LOCATION: <i>34</i> sec <i>27</i> T <i>82</i> N R <i>2</i> E <i>3</i> miles <i>SW</i> of <i>Stov.</i>	<i>hard sand</i>	20	57
(distance) (direction) (nearest town)	<i>blue clay</i>	57	250
WELL PURPOSE: <i>house</i> (home, irrigation, municipal, industrial)	<i>hard</i>	250	270
WELL COMPLETION DATA:	<i>blue clay</i>	270	301
(1) diameter (inches) <i>2"</i>			
(2) total depth (feet) <i>301'</i>			
(3) static water level (feet) <i>110</i> below above top of ground.			
(4) casing <i>Plastic, 260'</i> (material) (depth)			
<i>2"</i> (size) if telescope see back.			
(5) screen <i>10'</i> , <i>260'</i> (length) (depth to top)			
<i>2"</i> , <i>Plastic</i> (size) (material)			
(6) pump <i>1 1/2</i> <i>5</i> (HP) (yield gpm)			
<i>Just</i> (type power)			
(7) electric log <i>Just</i> (yes or no)			
<i>M. N. H.</i> (organization running log)			
(8) how well bottom plugged <i>3/4 well</i>			
DRILLERS REMARKS:			


**CODED**

OCT 14 1970

MISS. BD. OF  
 WATER COM.

If well telescopes please sketch and show depths.

GROUND LEVEL

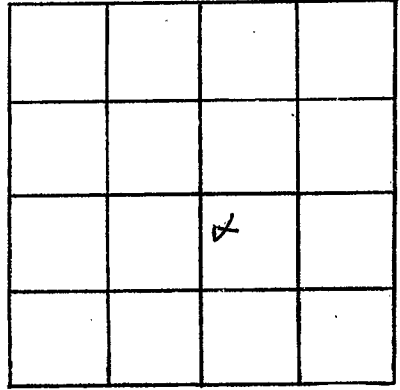

SECTION 27

Please indicate well location X.

ADDITIONAL INFORMATION

If more than one screen,  
show locations of each on sketch.