

RANKIN  
 U52  
 8-2-66

MISSISSIPPI BOARD OF WATER COMMISSIONERS

WATER WELL DRILLERS LOG

**CODED**

Date: August 2, 1966, Driller Burney Water Well Service County Rankin  
346 (Name)

- (1) Owner of Land: Jessie Lee Thompson  
 (Name)  
Route 1, Box 462  
Florence, Miss.
- (2) Location: 1/4, 1/4, Sec. 7 T 3<sup>N</sup> R 2<sup>E</sup>  
3 miles South-West of Florence  
 (distance) (direction) (Nearest Town)
- (3) Topography: Hilly  
 (Hilly) (Flat) (Level)
- (4) Purpose of Well: Domestic  
 (Domestic Irrigation, Municipal, Industrial, Other)


Description & Color of Materials Sand, Clay, Red Clay, Shell, etc.	Thick-ness Feet	Depth Feet
Red top soil	4	4
Pipe clay	8	12
Hard Grey formation	18	30
Black Shale	34	64
Fine black sand	1	65
Hard black shale	5	70
Rock or limestone	17	87
Blue clay & shale	31	118
Clay with sand layers	25	143
Fine sand	5	148
shale	15	163

Information upon completion of well:

- (1) Diameter 4" inches.
- (2) Total Depth 163 feet.
- (3) Water Level 41 feet below top of ground.
- (4) Cased to 142', Size 2"
- (5) Screen: Size 2", Length 5'
- (6) Were any formations sealed against pollution?  
X yes,        no.

If YES depth of formation From surface  
 Why To prevent surface pollution  
 Drillers Remarks: Sanitary well seal used

**CODED**

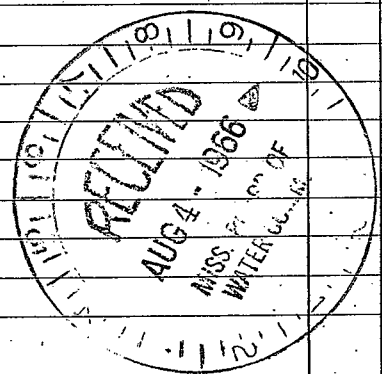

(Use Back Side)

Well No.

