

RANKIN

535V 57
5-22-62

WATER WELL DRILLERS LOG

FOREST DRILLING SERVICE

CODED

Date: 5/21, 1962, Driller: 231 Highway 35 North County: Rankin
FOREST, MISSISSIPPI

(1) Owner of Land: Morning Star Baptist Church
(Name)
Star, Miss.
(Address)

(2) Location: 1/4, 1/4, Sec. 18 T. 33 R. 3
2 miles north of Star
(distance) (direction) (Nearest Town)

(3) Topography: _____
(Hilly) (Flat) (Level)

(4) Purpose of Well: Church use
(Domestic Irrigation
Municipal, Industrial, Other)

Description & Color of Materials Sand, Clay, Red Clay, Shell, etc.	Thick- ness Feet	Depth Feet
Brown Clay	0	28
Blue Clay	4	32
Hard clay	40	72
Clay + Shls Rock	10	82
Hard Shale	30	112
Hard Shale + Rock	10	122
Hard Shale	16	138
Shale + Rock	4	142
Fine sand	5	147
Clay + Rock	25	172
Hard Shale	100	272
Shale + Shls. Sand	10	282
Shale	45	327
Rock	1	328
Shale	12	340
Rock	18	358
Shale	14	372
Shale + Shls sand	10	382
Shale	8	390
Fine sand	10	400

Information upon completion of well:

(1) Diameter 2" inches.

(2) Total Depth 400 feet.

(3) Water Level 99 feet below top of ground.

(4) Cased to 390', Size 2"


(5) Screen: Size 2", Length 10ft.

(6) Were any formations sealed against pollution?
_____ yes, no.

If YES depth of formation _____

Why _____

Drillers Remarks: _____

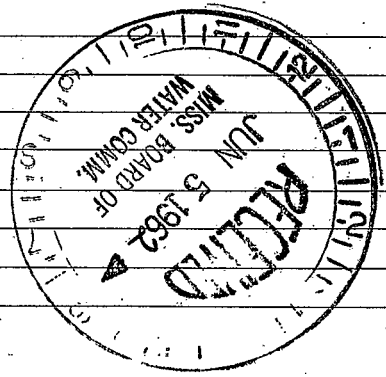

(Use Back Side)

Well No.

1000